

Ellis


Section 9 Township 11 Range 18W

Well No. #7 Meistrell

Company Shade & Berry

NORTH

WEST

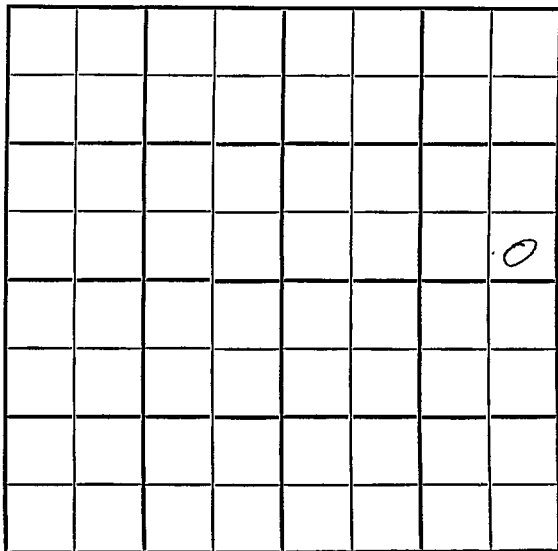

EAST

SOUTH

Ellis

KANSAS

SEC. 9	TWP. II	R. 18W
-----------	------------	-----------

WELL NO.

#7-Meistrell

FARM

COMPANY

Shade & Berry

CONTRACTOR

Transit

WILDCAT

____ FT. FROM N. LINE


10

____ FT. FROM S. LINE

____ FT. FROM E. LINE

____ FT. FROM W. LINE

SE SE NE

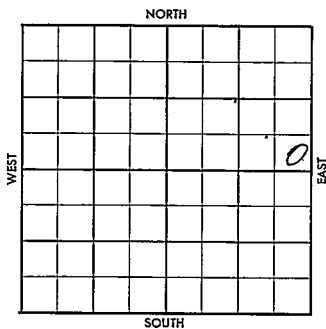

1956

ELEVATION

1883 RB

REPORT

7-3

Comm. 6-26-56
Drlg. 2235

7-25

8 5/8" @ 1196 w/650

DST 2918-31 op 40 min, rec. 10' mud,
BHP 480/20"DST 3151-87 op 2 hrs. rec. 160' MSW,
BHP 1010/20".DST 3291-3321 op 45 min, rec. 6' mud,
BHP 80/20"

D & A

Anh. 1180'; Tp. 2873'; H. 3100';

Tr. 3120'; L. 3143'; C. 3398';

S. 3490'; A. 3513';

TD 3563';

ABANDONED

County Ellis Elev. _____
 Sec. 9 Twp. 17 Rge. 18W
 Company Shade & Berry
 Farm Name Weistrell No. 7

TOPS	DEPTH	LOG	DATUM	Loc. in Sec.
Anh.				SE SE NE 10' SL
Tr.				
H.				
Tr.				
Dg.				
BL.				
L.				Geol. _____
K.C.				Contr. _____
B.K.C.				
Ce.				Transit
C.				
M.				Pool
M.				Summit
K.				Widest
Mz.				
Mo.				
V.				
S.				
S.				
A.				
R.				
PE.				
G.				
TD.				

FIRST REPORT
 JUL 3 '56

Date Comm. 6-26-56
 drlg. 2235

JUL 1 1956

S.S.

CORRECTION

FORM 513 SUNRAY

County Ellis Elev. 1883 RB
 Sec. 9 Twp. 11 Rge. 18W
 Company Shade & Berr
 Farm Name Heistrell No. 71

TOPS	DEPTH	LOG	DATUM	Loc. in Sec.
Anb.	1180			ST. 34 NE
Tr.	12873			10' SL
H.	13100			
Tr.	3120			
Dg.				
BL.				
L.	3143			
K.C.				Geol.
B.K.C.				Contr.
Ce.				Transit
C.	3398			Pool BURNETT
M.				Wildcat
M.				
K.				
Mz.				
Mo.				
V.				
S.	3490			ABANDONED
S.				
A.	3513			
R.				
PE.				
G.				
TD.	3563			

Date Comm. 6-24-56
 drlr. 2235 JUL 11 '56 8 5/8 @ 1196/650
DST 2918-31 40" rec 10' Md
BHP 480/20" DST 3151-87
2 hrs rec 160' MSW BHP 1010
120" DST 3291-3321
rec 6' Md BHP 80/20" ϕ
3350 JUL 18 '56 JUL 13 '57

DEA