


Section 9 Township 11 Range 23W

Well No. 2 Erickson

Company Imperial Drlg.

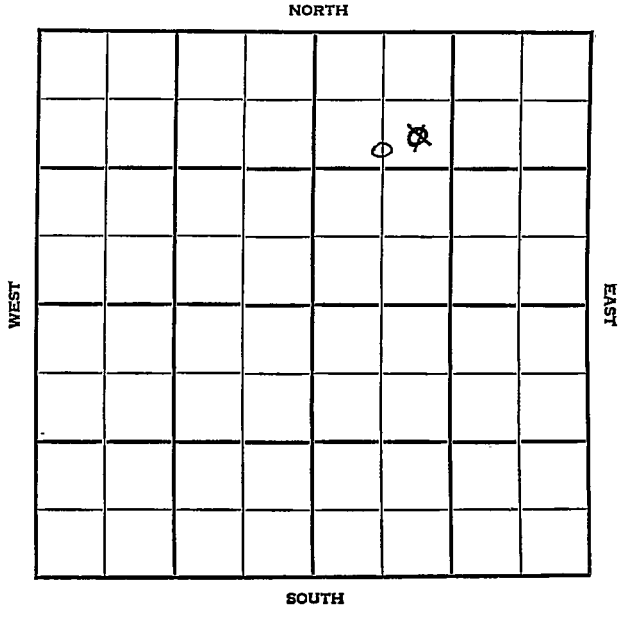

Map No. _____ Sec. 9 Twp. 11 R. 23W

Well No. 2 Erickson

Imperial Drlg. Company

CORRECTION

Contractor

C S $\frac{1}{2}$ NW NE

SECTION PLAT

990 Ft. from N. Line

_____ Ft. from S. Line

_____ Ft. from E. Line

660 Ft. from W. Line

		o	

Trego County

Location _____

Rig up _____

Drilling and Remarks:

Reported

SE NW NE

RECORD

Cased _____ in., _____ ft.

Sand _____

Gas _____

Oil _____

Total Depth _____

PRODUCTION

1st 24 hrs. Nat. _____

1st 24 hrs. after shot _____

Gas _____ Cu. Ft.

Dry Hole _____

Abandoned _____

Date

OCT 27 1954

FABEN GILDIRAP

Scout

County Trego State Kansas

Sec. 9 (Blk. 11 (Sur. 23W (Twp.) (Rge.) Map No.

Operator Imperial Drlg.

Well No. 2 Farm Erickson

Elev. 2274 Location C S $\frac{1}{2}$ NW NE

990 Ft. From N Line NE

660 Ft. From W Line Quarter

Ist. Report

Completion NOV 23 1954

Remarks NW Wakeeney Pool

Co. tools

Spudding Date 10-16-54

Drlg. Data Oil well TD 3762

8" @ 214 Anhy1751 Heeb. 3474

Lans. 3518 DST 3521-37 open 1 hr.

Rec. 6' mud 0# DST 3535-51 open 1 hr.

Rec. 450' oil 550' gcmo 835#

DST 3558-74 open 1 hr. Rec. 60' gas

45' ocm 500# DST 3609-16 open 1 hr.

Rec. 750' gas 25' muddy oil 20' oil

800# TD 3762 5" @ 3762 CO to TD

24/ 3652-57 1000 A 10 go 75 gwph

PB 3626 24/ 3546-51 1 boph 500 A

11 boph Comp. 997 bopd

FABEN GILSTON