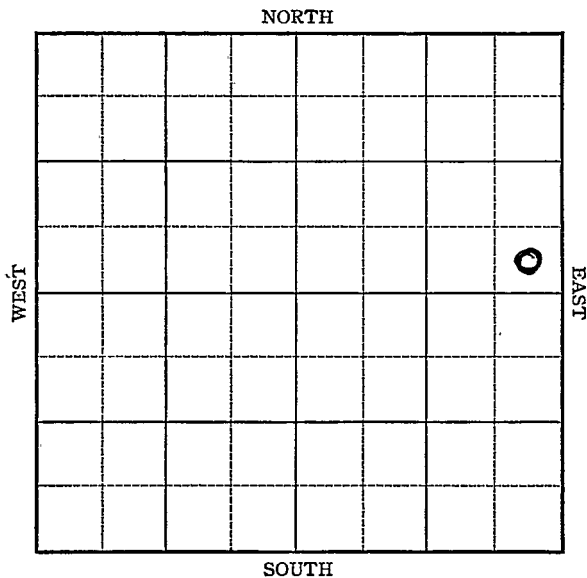


Wallace

KANSAS

Form 51-5M 5-37 Petrol


Section 9 Township 11 Range 40-WWell No. 1 - ParkerCompany Wilcox O&G

Sec. 9 Twp. 11 R. 40WWell No. #1 Parker FarmWilcox O&G Company

SE NE Special

 Ft. from N. Line330 Ft. from S. Line330 Ft. from E. Line Ft. from W. Line

Elev. 3662

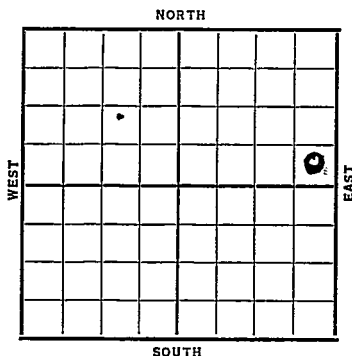

Date	REPORT
1937	
8/25	B.R.R.
9/3	R U R
9/10	"
9/15	"
9/24	"
10/2	"
10/8	"
10/15	10" @ 165'. SD 3480' for repairs.
10/22	Sample tops: Dakota 1970; Morrison 2385; Red beds 2655'. Anhy 2700'. Blaine 2940'. Cedar Hills 3190'. Show gas 4070-80'. Shut down 4084 for repairs.
10/29	Drlg. 4860'.
11/5	Drlg. 5100'.
	OVER

1937

11/10 Miss. 5108'.

T.D. 5278'.

No shows.

ABANDONED

3662

Hallam KANSAS

Map No. No Map Sec. 9 Twp. 11 R. 40wWell No. 1- ParkerWilcox Oil & Gas Company**FIRST REPORT**

Contractor

Special SECTION PLATse ne
_____ Ft. from N. Line330 Ft. from S. Line330 Ft. from E. Line

_____ Ft. from W. Line

			0

Location _____

Rig up _____

Drilling and Remarks:

B. R. R.**RECORD**

Cased _____ in., _____ ft.

Sand _____

Gas _____

Oil _____

Total Depth _____

PRODUCTION

1st 24 hrs. Nat. _____

1st 24 hrs. after shot _____

Gas _____ Cu. Ft.

Dry Hole _____

Abandoned _____

Date

AUG 25 1937

19

H. D. Hatfield

Scout

Wallace KANSAS

Map No. No Map Sec. 9 Twp. 11 R. 40WWell No. 1 ParkerWilcox Oil & Gas Company

Contractor

ABANDONED

SE NE

 Ft. from N. Line330 Ft. from S. Line330 Ft. from E. Line Ft. from W. Line

SECTION PLAT

			0

Location Rig up

Drilling and Remarks:

No showsD & A

RECORD

Cased in., ft.Sand MISS 5108Gas Oil Total Depth 5278

PRODUCTION

1st 24 hrs. Nat. 1st 24 hrs. after shot Gas Cu. Ft.Dry Hole Abandoned

Date

H. D. Hatfield

NOV 10 1937

Scout