


Section 9 Township 11 Range 17W

Well No. #1 Mock

Company Westgate Greenland

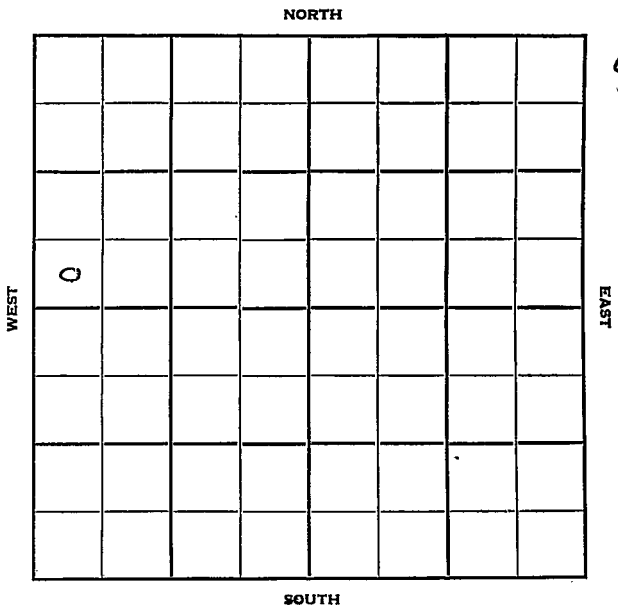

Sec. 9 Twp. 11 R. 17 W

Well No. # 1 Mock Farm

Westgate-Greenland Company

Contractor


Ft. from N. Line

330 Ft. from S. Line

Ft. from E. Line

330 Ft. from W. Line

SW SW NW

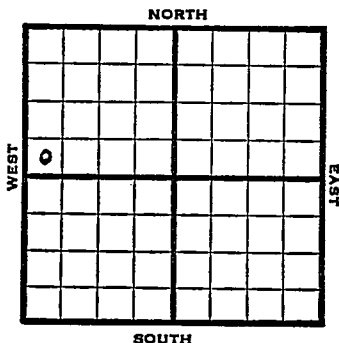

1952	Elev. 1872'	REPORT
1/30	Spud 1-29-52 10" @ 218'	WOC
2/6	Anhy 1125 Drlg. 3045	Topeka 3022
2/13	Spud 1-29-52 D&A TD 3503' 10" @ 218'	Top. 3022 Tor. 3096
	Anhy 1125	
	Heeb. 3076	
	Lans. 3117	
	DST 3099-3138 open 1 hr.	
	Rec. 4' mud	
	B KC 3383	Cong. 3393
	Arb. 3473	
	TD 3503	
	D&A	

ABANDONED

