

11-11-9W

SIDE ONE

STATE CORPORATION COMMISSION OF KANSAS  
OIL & GAS CONSERVATION DIVISION  
WELL COMPLETION OR RECOMPLETION FORM  
ACO-1 WELL HISTORY  
DESCRIPTION OF WELL AND LEASE

Operator: License # 3818  
Name Charlie Kosarek  
Address 1100 NW Loop 410, Suite 611  
City/State/Zip San Antonio, TX 78213

Purchaser

Operator Contact Person Charlie Kosarek  
Phone (512)-377-3214

Contractor: License # 8241  
Name Emphasis Oil Operations

Wellsite Geologist Mike Bair  
Phone (913)-483-6393

Designate Type of Completion  
 New Well  Re-Entry  Workover  
 Oil  SWD  Temp Abd  
 Gas  Inj  Delayed Comp.  
 Dry  Other (Core, Water Supply etc)

If **OWNO**: old well info as follows:  
Operator  
Well Name  
Comp. Date  
Old Total Depth

WELL HISTORY

Drilling Method:  Mud Rotary  Air Rotary  Cable  
8/30/88 9/8/88 9-8-88  
Spud Date Date Reached TD Completion Date  
4305'  
Total Depth PBTD  
Amount of Surface Pipe Set and Cemented at 421 feet  
Multiple Stage Cementing Collar Used?  Yes  No  
If yes, show depth set... feet  
If alternate 2 completion, cement circulated from... feet depth to... w/... SX cmt  
Cement Company Name  
Invoice #

API NO. 15-105-20,017  
County Lincoln  
SW SE SE Sec. 11. Twp. 11S Rge. 9.  East  West

330 Ft North from Southeast Corner of Section  
990 Ft West from Southeast Corner of Section  
(Note: Locate well in section plat below)


Lease Name Clarence Lessor Well # 1

Field Name

Producing Formation

Elevation: Ground 1486' KB 1491'

Section Plat

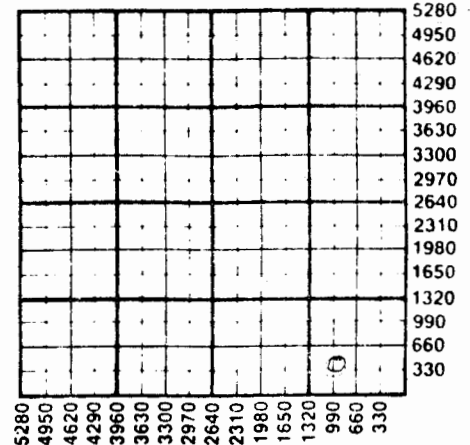

WATER SUPPLY INFORMATION

Disposition of Produced Water:  Disposal  Repressuring  
Docket #

Questions on this portion of the ACO-1 call:  
Water Resources Board (913) 296-3717

Source of Water:  
Division of Water Resources Permit #  
 Groundwater... Ft North from Southeast Corner (Well) ... Ft West from Southeast Corner of Sec Twp Rge East West  
 Surface Water 1320 Ft North from Southeast Corner (Stream, pond etc) 5280 Ft West from Southeast Corner Sec 24 Twp 11S Rge 9 East  West  
 Other (explain) (purchased from city, R.W.D. #)

INSTRUCTIONS: This form shall be completed in triplicate and filed with the Kansas Corporation Commission, 200 Colorado Derby Building, Wichita, Kansas 67202, within 120 days of the spud date of any well. Rule 82-3-130, 82-3-107 and 82-3-106 apply. Information on side two of this form will be held confidential for a period of 12 months if requested in writing and submitted with the form. See rule 82-3-107 for confidentiality in excess of 12 months. One copy of all wireline logs and drillers time log shall be attached with this form. Submit CP-4 form with all plugged wells. Submit CP-111 form with all temporarily abandoned wells.

All requirements of the statutes, rules and regulations promulgated to regulate the oil and gas industry have been fully complied with and the statements herein are complete and correct to the best of my knowledge.

Signature Charlie Kosarek  
Title Operator Date 11-4-88

Subscribed and sworn to before me this 14th day of November 1988  
Notary Public Joann Laymon  
Date Commission Expires 5-12-90



K.C.C. OFFICE USE ONLY  
 Letter of Confidentiality Attached  
 Wireline Log Received  
 Drillers Timelog Received  
Distribution  
 KCC  SWD/Rep  NGPA  
 KGS  Plug  Other (Specify)

Form ACO-1 (5-86)

NOV 6 9 1988  
KANSAS GEOLOGICAL SURVEY  
WICHITA BRANCH

Sec. 11 Twp. 11S Rge. 9W