

KANSAS

Ellis


FORM 51 5M 1-42 PETROL

Section 1 Township 12 Range 18-W

Well No. #1 Karlin

Company Carter Oil

NORTH Walters Pool

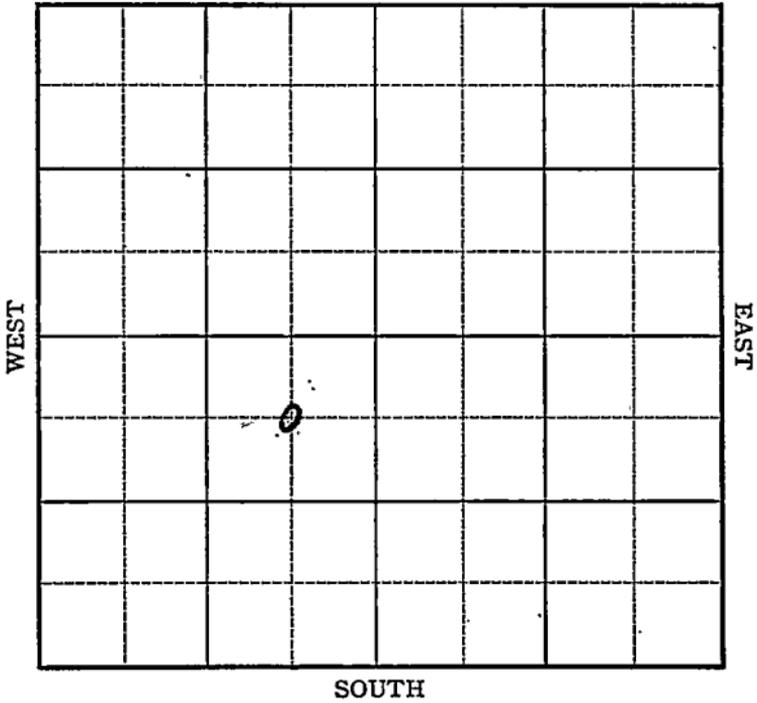

Sec. 1 Twp. 12 R. 18-W

Well No. #1 Karlin Farm

Carter Oil Company

(Walters)


660 Ft. from N. Line

_____ Ft. from S. Line

660 Ft. from E. Line

_____ Ft. from W. Line

Elev. 2095

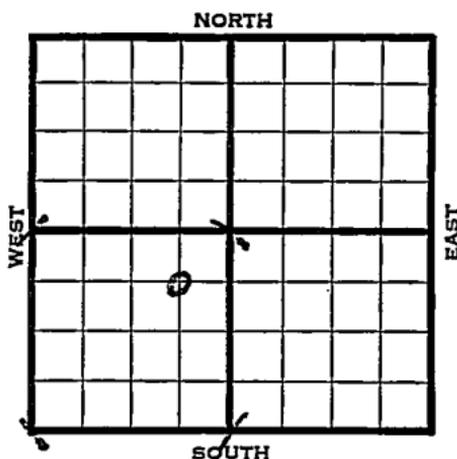

1942

REPORT

2/11

Location

2/19

"

2/26

8" - 277' Drlg. 1348'

3/5

Anhy. 1348' Drlg. 3126'

3/12

Topeka 3070' S.O. Lans. 3352'

S.O. 3352-3600' Arb. 3637' Drlg.

3/19

5" - 3637' 500 acid. Pump 10 oil.

3/25

Arb. 3637'

5" - 3637'

T.D. 3645'

2500 acid.

Water.

ABANDONED

Ellis


KANSAS

Map No. 71 Sec. 1 Twp. 12 R. 18WWell No. 1 KarlinCarter Oil Company**FIRST REPORT** Contractor

C NE SW

660 Ft. from N. Line Ft. from S. Line660 Ft. from E. Line Ft. from W. Line

SECTION PLAT

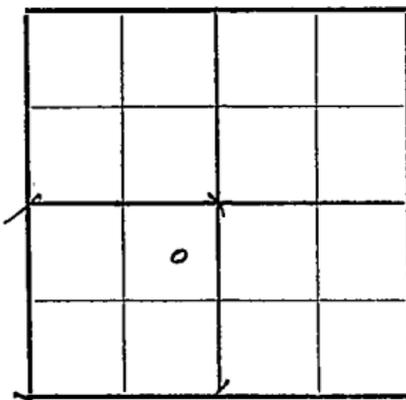

WALTERS POOL

Location XXRig up

Drilling and Remarks:

RECORD

Cased in., ft.Sand Gas Oil Total Depth

PRODUCTION

1st 24 hrs. Nat. 1st 24 hrs. after shot Gas Cu. Ft.Dry Hole Abandoned

Date

FEB 1 1 1942 19S. J LEWIS

Scout

Ellis

KANSAS

Map No. 71 Sec. 1 Twp. 12 R. 18WWell No. 1 KarlinCarter Oil

Company

ABANDONED

Contractor

SECTION PLAT

	0		

C NE SW

660 Ft. from N. Line

_____ Ft. from S. Line

660 Ft. from E. Line

_____ Ft. from W. Line

WALTERS POOL

RECORD

Location _____

Cased _____ in., _____ ft.

Rig up _____

Sand _____

Drilling and Remarks:

Gas _____

Oil _____

Cr 8 3637Total Depth 36455" @ 36372500 acidWater.

PRODUCTION

1st 24 hrs. Nat. _____

1st 24 hrs. after shot _____

Gas _____ Cu. Ft.

Dry Hole _____

Abandoned 1

Date

MAR 25 1942 19S. I. LEWIS Scout