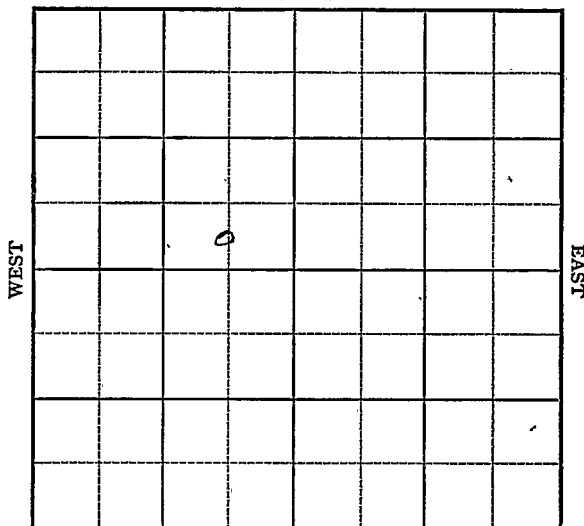


KANSAS

Ellis

Section 1 Township 12 Range 18WWell No. 1 KarlinCompany Keyes Drlg.Wildcat
NORTH

SOUTH

KANSAS

Ellis

18W

Sec. 1 Twp. 12 R. 18W

Well No. #1 Karlin Farm

Keyes Drlg. Company

Wildcat

 Ft. from N. Line

330'


 Ft. from S. Line

660'

 Ft. from E. Line

 Ft. from W. Line

C S L SE NW

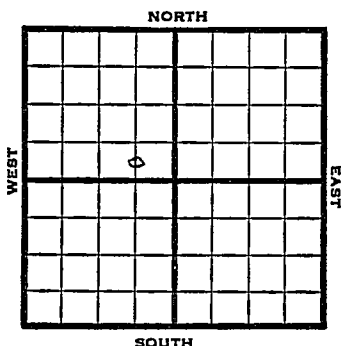

1949

Elev 2112'

REPORT

3/23

Location

3/30

10" @ 159'

Drlg 3203'

4/6

TD 3697'

Arb. 3686'

Aband.

ABANDONED

Kansas

Map No. _____ Sec. 1 Twp. 12 R. 18WWell No. 1 Karlin

Keyes Drlg.


Company _____

FIRST REPORT

Contractor _____

C S L SE NW

SECTION PLAT

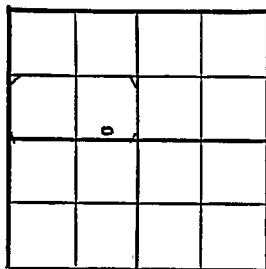

_____ Ft. from N. Line

330 Ft. from S. Line660 Ft. from E. Line

_____ Ft. from W. Line

Ellis County

Location X

Rig up _____

Drilling and Remarks: _____

RECORD

Cased _____ in., _____ ft.

Sand _____

Gas _____

Oil _____

Total Depth _____

PRODUCTION

1st 24 hrs. Nat. _____

1st 24 hrs. after shot _____

Gas _____ Cu. Ft.

Dry Hole _____

Abandoned _____

Date

MAR 23 1949

19

S. J. LEWIS

Scout

Kansas

Map No. 111 Sec. 1 Twp. 12 R. 18WWell No. 1 Karlin

Keyes Drlg. Company

ABANDONED

Contractor

C S L SE NW

E. 2112
SECTION PLAT Ft. from N. Line330 Ft. from S. Line660 Ft. from E. Line Ft. from W. Line

Ellis County

Location Rig up

Drilling and Remarks:

Cor 83686.

RECORD

Cased in., ft.Sand Gas Oil Total Depth 2687

PRODUCTION

1st 24 hrs. Nat. 1st 24 hrs. after shot Gas Cu. Ft.Dry Hole Abandoned

Date

APR 6 1949

19

S. J. LEWIS

Scout