

Ellis KANSAS

DX 78-1

Section 1 Township 12 Range 18W

Well No. 1 Karlin

Company Walters Drig.

NORTH

WEST

EAST

					0		

SOUTH

SEC. 1. TWP. Ellis KANSAS R. 12 18W

WELL NO. #1 Karin FARM

COMPANY Walters Drlg.


CONTRACTOR Walters
Walter Pool

330 Ft. from N. Line

Ft. from S. Line

Ft. from E. Line

990 Ft. from W. Line

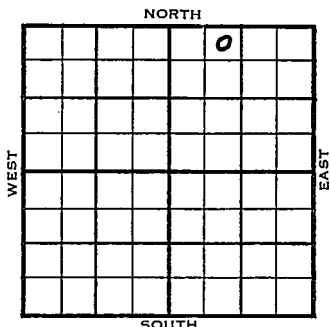

NE NW NE

Carter FO

1954 ELEVATION 2092' REPORT

~~7/14~~
~~2000~~

Location

9/1 Spud 8-1-54 Oil well TD 3636
8" @ 166 Heeb 3296 Tor. 3317
Lans. 3343 Cong. 3587 Simp. 3609
Arb. 3627 TD 3636 5" @ 3631
CO to 3636 FU 1600' fluid 1 1/2 hr.
FU 2265' fluid 8 hr. S/7.65 BOPH
14 hr. 17.5% wtr. PB 3634
SI 24 hr. S/3 BOPH 18% wtr. 17 hr.
Comp. 27 BOPD

COMPLETED

County Ellis State KansasSec. 1 (Blk.) 12 (Sur.) 18W Map No.Operator Walters Drig.Well No. 1 Farm KarlinElev. Location NE NW NE


330 Ft. From N Line NE990 Ft. From W Line Quarter1st. Report JUL 14 1954

Completion

Remarks Carter farmoutWalters - Contr.

Spudding Date

Drig. Data Walter PoolLocation

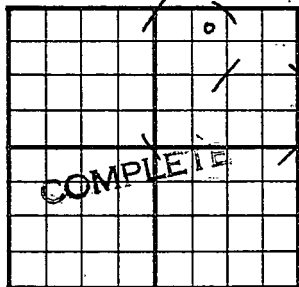County Ellis State KansasSec. 1 (Blk.) 12 (Sur.) 18W Map No.Operator Walters Drlg.Well No. 1 Farm KarlinElev. 2092 Location NE NW NE330 Ft. From N Line NE990 Ft. From W Line Quarter

1st. Report

Completion SEP 1 1954Remarks Walter PoolWalters - Contr.Spudding Date 8-1-54Drlg. Data Oil well TD 36368" @ 166 Heeb. 3296 Tor. 3317Lans. 3343 Cong. 3587 Simp. 3609Arb. 3627 TD 3636 5" @ 3631CO to 3636 FU 1600' fluid 1½ hr.FU 2265' fluid 8 hr. S/ 7.65 boph 14 hr.17.5% wtr. PB 3634 SI 24 hr.S/ 3 boph 18% wtr. 17 hr.Comp. 27 bopd

FABEN GILSTRAP