

Section 1 Township 12 Range 18W

Well No. 2 Karlin "A"

Company Bartlett & Walters

NORTH

							0

WEST

EAST

SOUTH

Ellis

KANSAS
KANSAS

SEC.	TWP.	R.
1	12	18 W

WELL NO. # 2 Karlin "A" FARM

COMPANY

CONTRACTOR Bartlett & Walters


Walters Drlg.
Bemis-Shutts Pool

_____ Ft. from N. Line

990 _____ Ft. from S. Line

330 _____ Ft. from E. Line

_____ Ft. from W. Line

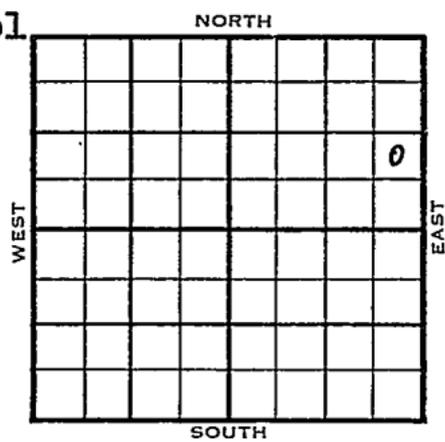

NE SE NE
Carter Farmout

1954	ELEVATION 2143'	REPORT
------	--------------------	--------

10/20 Spud 10-16-54
8" @ 173 Anhy 1389
Drlg. 2082'

11/3 Spud 10-16-54
D & A
TD 3767'
8" @ 173'
Anhy 1389', Top 3127', Heeb 3361'
KC 3406', Cong 3651' Simp sh. 3751'
Arb. 3758'
TD 3767'
D & A

ABANDONED,

County Ellis State Kansas

Sec. 1 (Blk. Twp.) 12 (Sur. Rge.) 18W Map No.

Operator Bartlett & Walters

Well No. 2 Farm Karlin "A"

Elev. Location NE SE NE

							6

990 Ft. From S Line NE

330 Ft. From E Line Quarter

Ist. Report OCT 20 1954

Completion

Remarks Carter farmout

Walters Drlg. - Contr.

Spudding Date 10-16-54

Drlg. Data Bemis-Shutts Pool

8" @ 173 Anhy 1389 drlg. 2082

FABEN GILSTRAP

