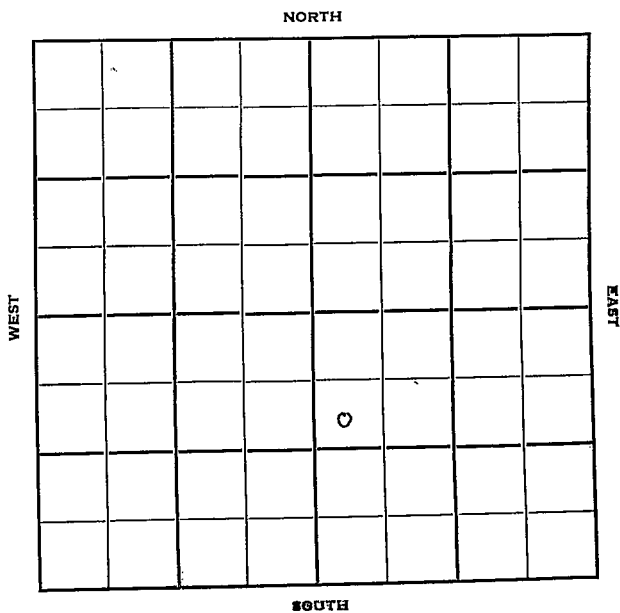


Section 1 Township 12 Range 18WWell No. #4 Karlin "A"Company Glenn Nye Drlg.

Ellis

KANSAS

Sec. 1 Twp. 12 R. 18 W

Well No. # 4 Karlin "A" Farm

Glenn Nye Drlg. Company

Walters Pool


990 Ft. from N. Line

Ft. from S. Line

Ft. from E. Line

330 Ft. from W. Line

SW NW SE

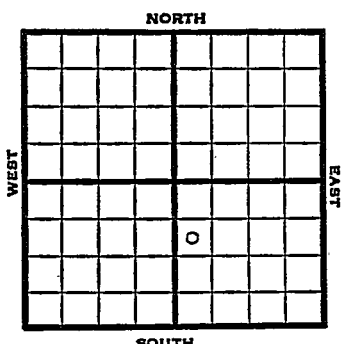

1951

Elev. 2108'

REPORT


8/15

Spud 8-10-51
8" @ 128'
Anhy 1361'
Drlg. 1395'


9/26

Spud 8-10-51
Oil Well TD 3681'
8" @ 128'
Anhy 1361' Heeb. 3306' KC 3348'
DST 3436-46 open 1/2 hr. Rec. 10' mud
Cong. 3598 Simp. 3604 Arb. 3631-81
5" @ 3680 CO to 3669'
18/ 3654-56 1 bo 3% wtr. ph
175 A S/ 10 boph 2% wtr.
Comp. 100 bopd 6% wtr.

COMPLETED

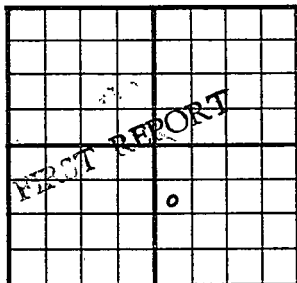County Ellis State KansasSec. 1 (Blk. Twp.) 12 (Sur. Rge.) 18W Map No.Operator Glenn Nye Drlg.Well No. 4 Farm Karlin "A"Elev. Location SW NW SE990' Ft. From N Line SE330 Ft. From W Line Quarter1st. Report AUG 15 1951CompletionRemarksSpudding Date 8-10-51Drlg. Data Walters Pool8" @ 128 Anhy 1361 drlg. 1395

J. E. TYRA

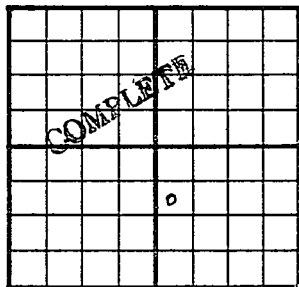County Ellis State KansasSec. 1 (Blk.
Twp.) 12 (Sur.
Rge.) 18W Map No.Operator Glenn Nye Drlg.Well No. 4 Farm Karlin "A"Elev. 2108 Location SW NW SE990 Ft. From N Line SE330 Ft. From W Line Quarter

1st. Report

Completion SEP 26 1951Remarks Walters PoolSpudding Date 8-10-51Drlg. Data Oil well TD 36818" @ 128 Anhy 1361 Heeb. 3306KC 3348 DST 3436-46 open $\frac{1}{2}$ hr.Rec. 10' mud Cong. 3598 Simp. 3604Arb. 3631-81 5" @ 3680 CO to 366918/ 3654-56 1 bo 3% water ph 175 AS/ 10 boph 2% water Comp. 100 bopd 6% wa