


Section 1 Township 12 Range 18WWell No. #6 Karlin (A)Company Glenn Nye

NORTH

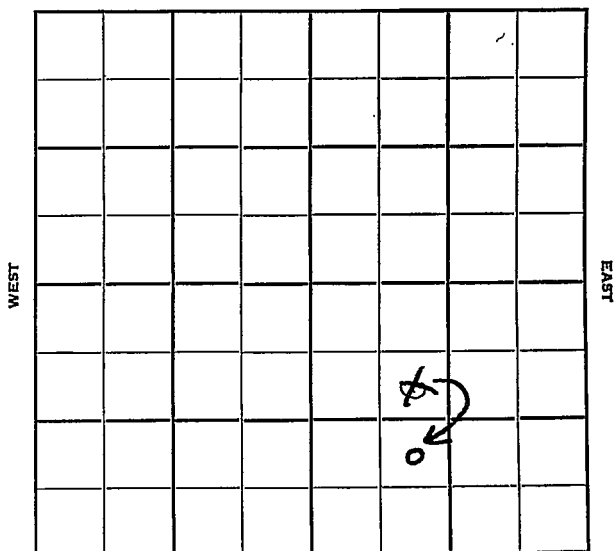

SOUTH

Sec. 1 Twp. 12 R. 18W

Well No. #6 Karlin(A) Farm

Glenn Nye Company

Glenn Nye Contractor


~~990~~ Ft. from N. Line

990 Ft. from S. Line

Ft. from E. Line

990 Ft. from W. Line

~~SE NW SE~~
NE SW SE

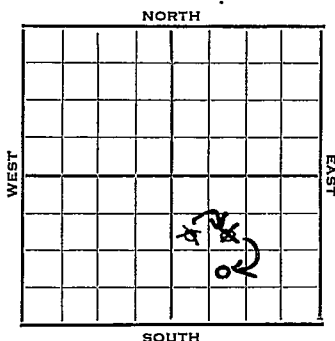


1952 Elev. 2111' REPORT

5/28 Spud 5-4-52
8" @ 114'
Anhy 1354'
Drlg. 2389'

6/11 Spud 5-24-52
D & A TD 3955' 8" @ 114'
Anhy 1354' Heeb 3321' Lans. 3363'
Cong. 3616' Simp. 3639' Arb. 3664'
DST 3665-58 open 20 min, rec 3' mud
DST 3666-83 open $\frac{1}{4}$ hr. rec 170' SOC
muddy water. TD 3955' 5" @ 3737
Comp. for SWD D & A

ABANDONED

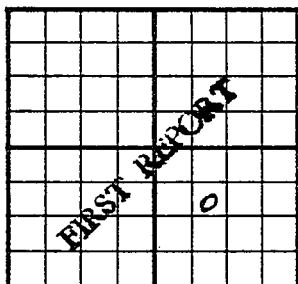County Ellis State KansasSec. 1 (Blk.) 12 (Sur.) 18W Map No.Operator Glenn NyeWell No. 6 Farm Karlin (A)Elev. Location SE NW SE990 Ft. From N Line SE990 Ft. From W Line Quarter1st. Report MAY 28 1952

Completion

Remarks

Glenn Nye - Contr.Spudding Date 5-24-52

Drlg. Data

8" @ 114 Anhy 1354 Drlg. 2389

J. G. McGEHEE

Map No. _____ Sec. 1 Twp. 12 R. 18WWell No. 6 Karlin "A"Glenn Nye

Company

CORRECTION

Contractor

NE SW SE

SECTION PLAT

_____ Ft. from N. Line

990 Ft. from S. Line

_____ Ft. from E. Line

990 Ft. from W. Line

Ellis County

Location _____

Rig up _____

Drilling and Remarks:

Reported

, SE NW SE

RECORD

Cased _____ in., _____ ft.

Sand _____

Gas _____

Oil _____

Total Depth _____

PRODUCTION

1st 24 hrs. Nat. _____

1st 24 hrs. after shot _____

Gas _____ Cu. Ft.


Dry Hole _____

Abandoned _____

Date

JUN 4 1952J. G. McGEHEE

Scout

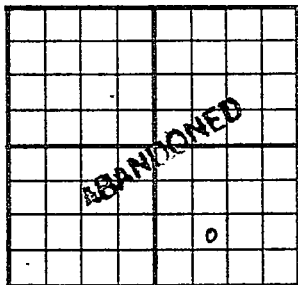County Ellis State KansasSec. 1 (Blk. Twp.) 12 (Sur. Rge.) 18W Map No.Operator Glenn NyeWell No. 6 Farm Karlin "A"Elev. 2111 Location NE SW SE990 Ft. From S Line SE990 Ft. From W Line Quarter

1st. Report

Completion JUN 11 1952

Remarks

Glenn Nye - Contr.Spudding Date 5-24-52Drlg. Data D & A TD 39558" @ 114 Anhy 1354 Heeb. 3321Lans. 3363 Cong. 3616 Simp. 3639Arb. 3664 DST 3665-68 open 20 min.Rec. 3' mud DST 3666-83 open $\frac{1}{4}$ hr.Rec. 170' soc muddy wtr. TD 39555" @ 3737 Comp. for SWDD & A

J. G. McGEHEE