


DX 78-1 Ellis

Section 1 Township 12 Range 18W

Well No. 9 Karlin "A"

Company Nye & Snell Drlg.

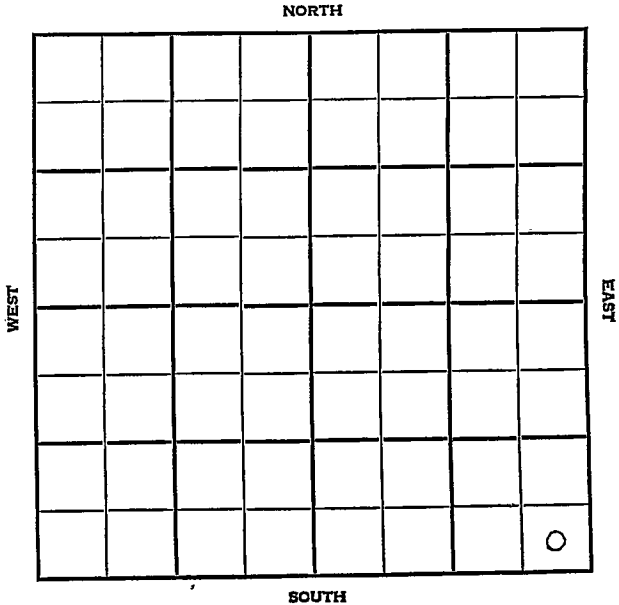

Ellis

SEC.	TWP.	R.
1	12	18W

WELL NO. #9 Karlin "A" FARM

COMPANY Nye & Snell Drlg.

CONTRACTOR Co. Tools.


Bemis-Shutts Pool NORTH

_____ Ft. from N. Line

380 _____ Ft. from S. Line

280 _____ Ft. from E. Line

_____ Ft. from W. Line

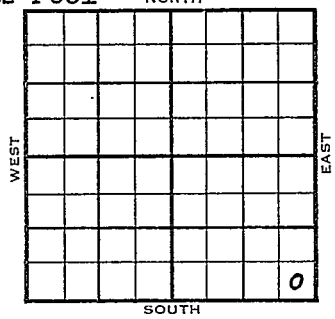

SE SE SE Twin

1955	ELEVATION 2150'	REPORT
------	--------------------	--------

4/27 Spud 4-20-55
8" @ 121'
Anhy 1391'
Drlg. 3025'

