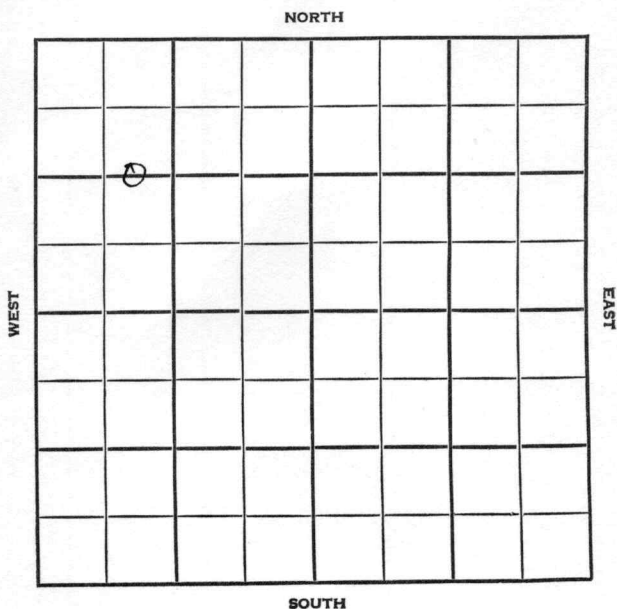


KANSASSection 1 Township 12 Range 18WWell No. 1 Karlin "B"Company Walters Drlg.

Ellis

KANSAS

SEC.	TWP.	R.
1	12	18W

WELL NO.

1 Karlin "B"

FARM

COMPANY

Walters Drlg.

CONTRACTOR

1320'

Ft. from N. Line

Ft. from S. Line

Ft. from E. Line

1150'

Ft. from W. Line

C E $\frac{1}{2}$ W $\frac{1}{2}$ NW

NORTH

WEST

EAST

SOUTH

	ELEVATION	REPORT
1955	2026'	
5/26	Comm 5-10-55 8" @ 169 Anh 1283 Tp 3018 Drlg 3174	
5/26	TD 3650' D & A Spud 5-10-55 8" @ 169 Tops: Anhy 1283', Topeka 3018' Heebner Sh 3251', Lansing 3297' B.K.C. 3544', Simpson 3588', Arbuckle 3608'. TD 3650' D & A	
	ABANDONED	

FIRST REPORT

ABANDONED

FORM 513 REV. SUNRAY


County Ellis Elev. 2026
 Sec. 1 Twp. 12 Rge. 18W
 Company Walters Drlg.
 Farm Name Karlin "B" No. 1

TOPS	DEPTH	DATUM
Cim. Anhydrite	1283	
Ft. Riley		
Howard		
Topeka	3018	
Heebner Sh.	3251	1225
Toronto Ls.		
Brown Lime		
Lansing	3297	1271
Kans. City		
B. K. C.		
Congl.	3544	1518
Miss.		
Kinderhook		
Misener		
Hunton		
Sylv. Maquo		
Viola		
Simpson	3588	1562
Smp.		
Gorham		
Arbuckle	3608	1582
Basal Sand		
Pre. Cam.		
T. D.	3650	

Loc. in Section
C E $\frac{1}{2}$ W $\frac{1}{2}$ NW

Drlg. Contr. _____

Pool

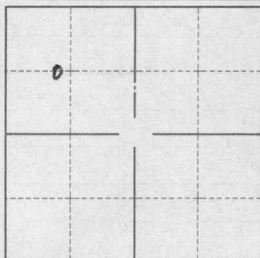

Date Comm. _____

Date Comp. MAY 25 '55

Spud 5-10-55 8" @ 169
 D & A

Co.

Lse.

No.

S.

T.

R.