

Ellis

Sec. 1 Twp. 12 R. 18W

Well No. #3 Kerlin "B" Farm

Glenn Nye Company

Walters Pool Contractor


Ft. from N. Line

330' Ft. from S. Line

Ft. from E. Line

330' Ft. from W. Line

SW SW SE

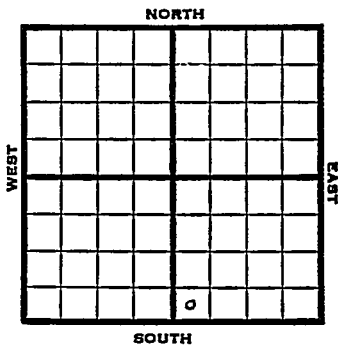

1950

Elev. 2125 REPORT

12/20
1951
1/31

Location

Spud 11/23/50

Oil well TD 3652

8" @132

Anhy 1378 Heeb 3325 Lans 3368

Cong. 3614 Simp. 3621 Arb. 3647

TD 3649

5" @3648 DD 3652

Comp. 443 bopd

COMPLETED

