

Ellis KANSAS

Section 10 Township 12 Range 17W

Well No. #1 T. Windholz

Company Skelly

Bemis Pool

NORTH

WEST	0								EAST

SOUTH

Sec. 10 Twp. 12 R. 17W

Well No. #1 T. Windholz Farm

Skelly


Bemis Pool Company

330' Ft. from N. Line

 Ft. from S. Line

 Ft. from E. Line

330' Ft. from W. Line

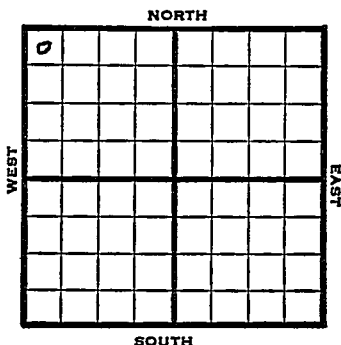

NW/C

1949

REPORT

12/7 Location

12/14 "

12/21 Drlg 500'

12/28 8"@ 1313'

Drlg 1420'

1950

1/4 TD 3635'

Anhy 1298'

8"@ 1313'

Lans 3314'

BST 3357-64 $\frac{1}{2}$ hr

* Rec 5' mud

Cong 3572'

Arb. 3600'

No shows

D&A

Aband.

ABANDONED

Kansas

Bemis Pool

Map No. _____ Sec. 10 Twp. 12 R. 17W


Well No. 1 T. Windholz

Skelly

Company

NW/6

Contractor

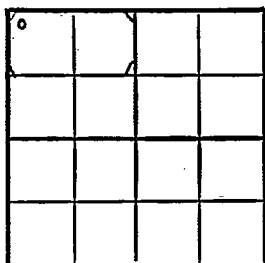FIRST REPORT
SECTION PLAT

330 Ft. from N. Line

Ft. from S. Line

Ft. from E. Line

330 Ft. from W. Line

Ellis County

Location X

Rig up

Drilling and Remarks:

RECORD

Cased in, ft.

Sand

Gas

Oil

Total Depth

PRODUCTION

1st 24 hrs. Nat.

1st 24 hrs. after shot

Gas Cu. Ft.

Dry Hole

Abandoned

Date

DEC 7 1949 19

S. J. LEWIS

Scout

Kansas

Map No. _____ Sec. 10 Twp. 12 R. 17W

Well No. 1 T. Windholz

Skelly _____ Company

Contractor

NW/C

SECTION PLAT

330


Ft. from N. Line

Ft. from S. Line

Ft. from E. Line

330

Ft. from W. Line

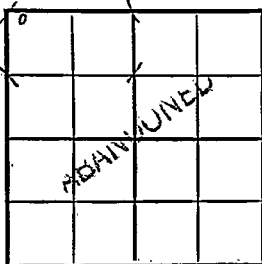

Ellis County

Location _____

Rig up _____

Drilling and Remarks:

Anky 1298

8" @ 1313

Lans. 3314

DST. 3357-64 1/2 hr.

rec. 5' mud

Cong. 3572

arb. 3600

no shows

D & A

RECORD

Cased _____ in. _____ ft.

Sand _____

Gas _____

Oil _____

Total Depth 3635

PRODUCTION

1st 24 hrs. Nat. _____

1st 24 hrs. after shot _____

Gas _____ Cu. Ft.

Dry Hole _____

Abandoned _____

Date

JAN 4 1950 19

J. E. Lysa Scout