

FORM 51 5M 10-41 PETROL

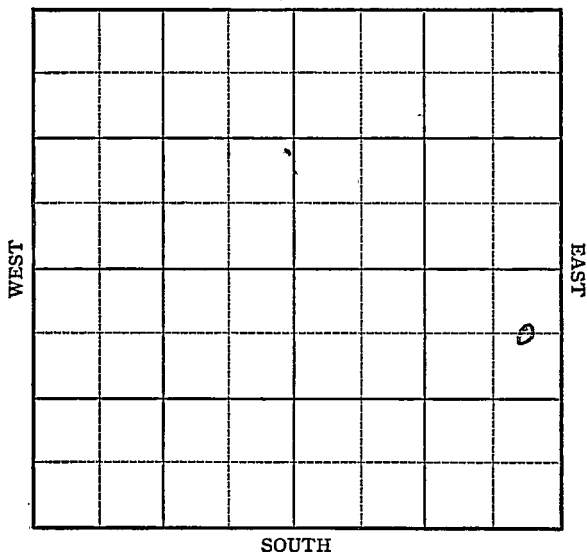
Ellis

Section 10 Township 12 . Range 18-W

Well No. 1 Baker

Company Stanolind

NORTH Koblitz Pool



Sec. 10 Twp. 12 R. 18-W

Well No. #1 Baker Farm

Stan olind

Company

(Koblitz)

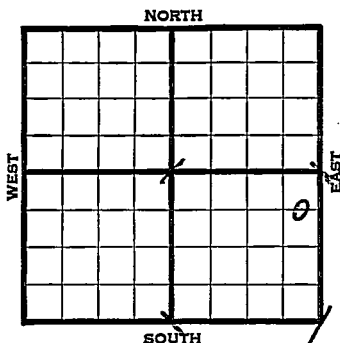
660 Ft. from N. Line

Ft. from S. Line

330 Ft. from E. Line

Ft. from W. Line

Elev. 2155

[illegible]

Ellis

KANSAS

Map No. 7/ Sec. 10 Twp. 12 R. 18WWell No. 1 BakerStanolind

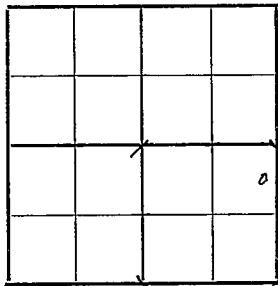
Company

FIRST REPORT

Contractor

C E L N E S E

SECTION PLAT

660 Ft. from N. Line Ft. from S. Line330 Ft. from E. Line Ft. from W. Line

KOBLITZ POOL

Location XXRig up

Drilling and Remarks:

RECORD

Cased in., ft.Sand Gas Oil Total Depth

PRODUCTION

1st 24 hrs. Nat. 1st 24 hrs. after shot Gas Cu. Ft.Dry Hole Abandoned

Date

JAN 14 1942 19 S. J. LEWIS

Scout

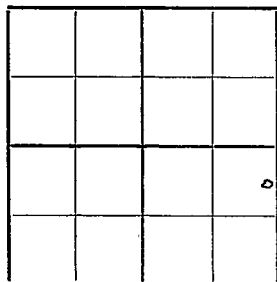
Ellis

KANSAS

Map No. 71 Sec. 10 Twp. 12 R. 18WWell No. 1 BakerStanolind CompanyABANDONED Contractor

C E L N E S E

SECTION PLAT

660 Ft. from N. Line Ft. from S. Line330 Ft. from E. Line Ft. from W. Line

KOBLITZ POOL

Location Rig up

Drilling and Remarks:

*Comp 3768**Cr 88831**Nashua*

RECORD

Cased in., ft.Sand Gas Oil Total Depth 3865

PRODUCTION

1st 24 hrs. Nat. 1st 24 hrs. after shot Gas Cu. Ft.Dry Hole Abandoned

Date

FEB 11 1942₁₉

S. J. LEWIS Scout