FORM 51 10M 7-48 PETROL


KANSAS Ellis

Section 10 Township 12 Range 18W

Well No. 1 Baker

Company Shawver - Graham

Bemin Pool

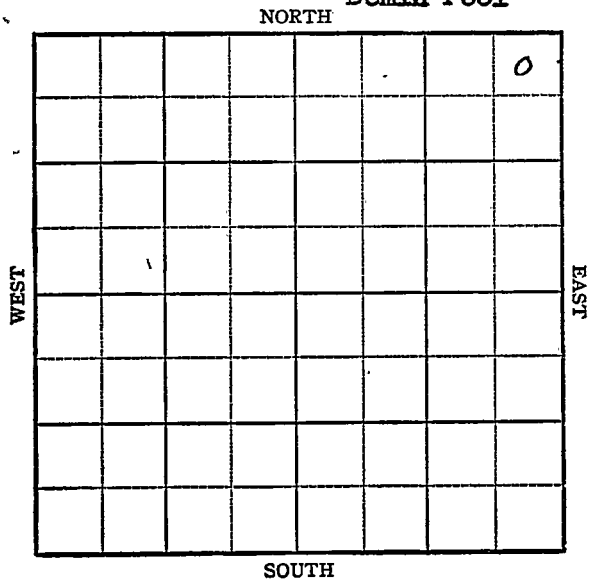

FORM 252-A
5M 10-48 PETROL

KANSAS Ellis V

Sec. 10 Twp. 12 R. 18W

Well No. #1 Baker Farm

Shawver - Graham Company

Bemis Pool


330' Ft. from N. Line

Ft. from S. Line

330' Ft. from E. Line

Ft. from W. Line

NE/C

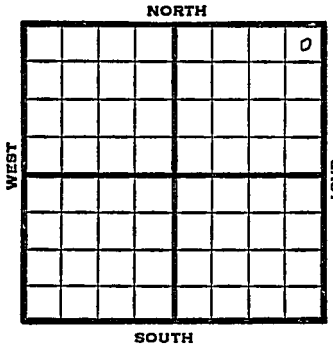

1948	Elev. 2123' REPORT
11/10	8" @ 165 Anhy 1868' Drlg. 2685'
11/16	Arbuckle 3648' TD 3649' 5" @ 3648'
11/23	"
11/30	TD 3659' 1000 acid Swb 3½ bbls oil PH
12/8	"
12/15	"
12/22	"
12/29	"
1949	
1/5	Arb. 3648' 5" @ 3648' 1000 acid Pump 35 oil Pot. Gr. 36° TD 3659'

COMPLETED

Form 26 200 Bks. 9-48 Petrol

Kansas

Bemis Pool

Map No. ____ Sec. 10 Twp. 12 R. 18W

Well No. 1 Baker

Shawver - Graham Company

FIRST REPORT Contractor

NE/C


330 Ft. from N. Line

____ Ft. from S. Line

330 Ft. from E. Line

____ Ft. from W. Line

SECTION PLAT

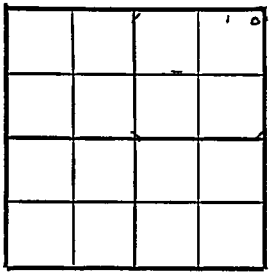

Ellis County

Location ____

Rig up ____

Drilling and Remarks:

8" @ 165

Anhy 1868

drlg. 2685

RECORD

Cased ____ in., ____ ft.

Sand ____

Gas ____

Oil ____

Total Depth ____

PRODUCTION

1st 24 hrs. Nat. ____

1st 24 hrs. after shot ____

Gas ____ Cu. Ft.

Dry Hole ____

Abandoned ____

Date

NOV 10 1948 19

S. J. LEWIS Scout

Form 26 200 Bks. 9-48 Petrol

Kansas

Bemis Pool

Map No. 71 Sec. 10 Twp. 12 R. 18W

Well No. 1 Baker


Shawver - Graham Company

COMPLETE Contractor

NE/C

El. 2123

SECTION PLAT

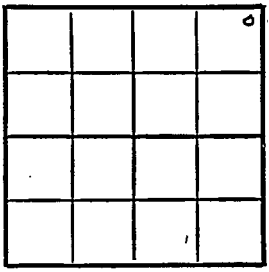

330 Ft. from N. Line

Ft. from S. Line

330 Ft. from E. Line

Ft. from W. Line

Ellis County

Location

Rig up

Drilling and Remarks:

Cir 3648'

5" @ 3648'

100 sacks C

Pump 30 bbls Pet

36 Oil

RECORD

Cased in., ft.

Sand

Gas

Oil ✓

Total Depth 3659

PRODUCTION

1st 24 hrs. Nat.

1st 24 hrs. after shot

Gas Cu. Ft.

Dry Hole

Abandoned

Date

JAN 5 1949 19

S. J. LEWIS Scout