


Section 10 Township 12 Range 18W

Well No. 1 Baker Bros.

Company Globe Oil Ref.

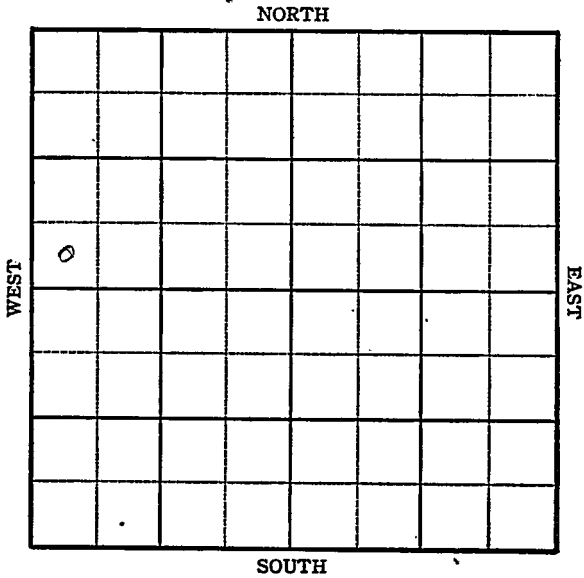

KANSAS

Ellis

Sec. 10 Twp. 12 R. 18-W

Well No. #1 Baker Bros. Farm


Globe Oil Ref. Company

 Ft. from N. Line

330 Ft. from S. Line

 Ft. from E. Line

330 Ft. from W. Line

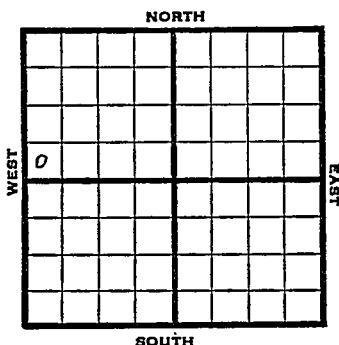

SW NW -

1945 Elev. 2185
6 REPORT

11/7 Location
11/14 RUR
11/21 12" @ 145
Drlg. 1000'
11/28 7" @ 1000'
Anhy. 1465
Drlg. 2906'
12/5 Drlg. 3707
12/12 Topeka 3140
Arb. 3750
TD 3802'

ABANDONED

KANSASKansas Pool Name WildcatMap No. 91 Sec. 10 Twp. 12 R. 18WWell No. 1 Baker Bros.

Globe Oil Ref.

Company

FIRST REPORT

Contractor

SW NW

SECTION PLAT

Ft. from N. Line

330 Ft. from S. Line

Ft. from E. Line

330 Ft. from W. Line

Ellis County

Location X

Rig up

Drilling and Remarks:

RECORDCased in. ft.Sand Gas Oil Total Depth **PRODUCTION**1st 24 hrs. Nat. 1st 24 hrs. after shot Gas Cu. Ft.Dry Hole Abandoned

Date

NOV 7 1945

19

S. J. LEWIS

Scout

KANSAS

Kansas Pool Name WildcatMap No. K-71 Sec. 10 Twp. 12 R. 18WWell No. 1 Baker Bros.

Globe Oil Ref. _____ Company

ABANDONED

Contractor


SW NW

E. 12/85
SECTION PLAT

_____ Ft. from N. Line

330 Ft. from S. Line

_____ Ft. from E. Line

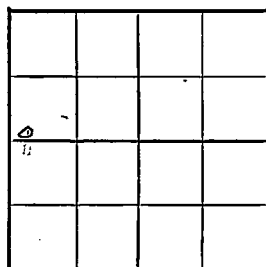330 Ft. from W. Line

El is County

Location _____

Rig up _____

Drilling and Remarks:

*Stop at 3140**Per 3750*

RECORD

Cased _____ in., _____ ft.

Sand _____

Gas _____

Oil _____

Total Depth 3802

PRODUCTION

1st 24 hrs. Nat. _____

1st 24 hrs. after shot _____

Gas _____ Cu. Ft.

Dry Hole _____

Abandoned _____

Date

DEC 12 1945 19

S. J. LEWIS Scout