


Section 10 Township 12 Range 18W

Well No. #1 Baker "D"

Company Petroleum Inc. & Isern Drlg.

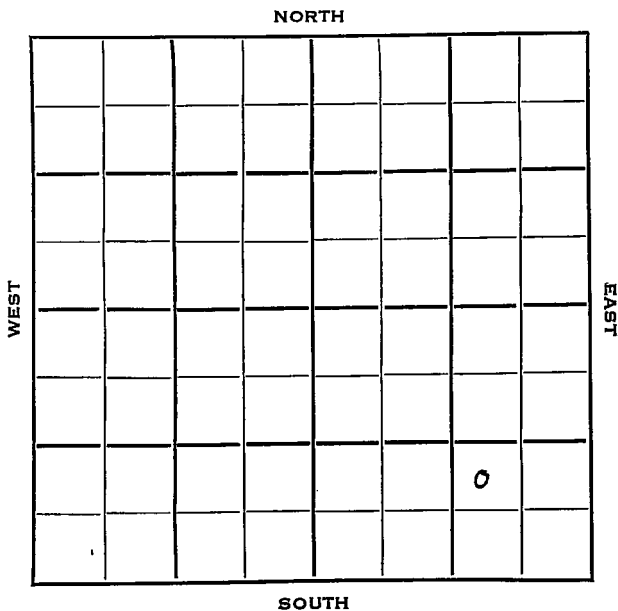

Ellis

KANSAS

SEC.	TWP.	R.
10	12	18 W

WELL NO.

1 Baker "D"

FARM

COMPANY

Petroleum Inc. & Isern Drlg.

CONTRACTOR

Garvey

Walter Pool


_____ Ft. from N. Line

990 _____ Ft. from S. Line

990 _____ Ft. from E. Line

_____ Ft. from W. Line

NW SE SE

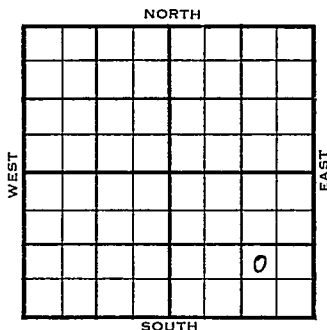

	ELEVATION	REPORT
1954	2164'	
1/27	Spud 1-22-54 8" @ 194' Drlg. 2885'	
2/3	Heeb 3378 Tor 3401 Lans 3421 Arb. 3697 DST 3698-3705, 1 hr, 15' SOCM 625# RTD 3705' 5" @ 3700	
2/10	NR	
2/17	Spud 1-22-54 D & A TD 3705' 8" @ 194' Heeb 3378', Tor 3401', Lans 3421' Arb 3697' DST 3698'-3705' opn 1 hr, rec 15' socm 625# TD 3705' 5" @ 3700' CO to 3705' 250 A 4½ bfph 95% Wtr. Simp 3690' D & A	
ABANDONED		

