

KANSAS

Form 51-5M-7-39-Palace


Ellis

Section 10 Township 12 Range 18-W

Well No. #1 Oliver

Company Gulf

NORTH Walters Pool

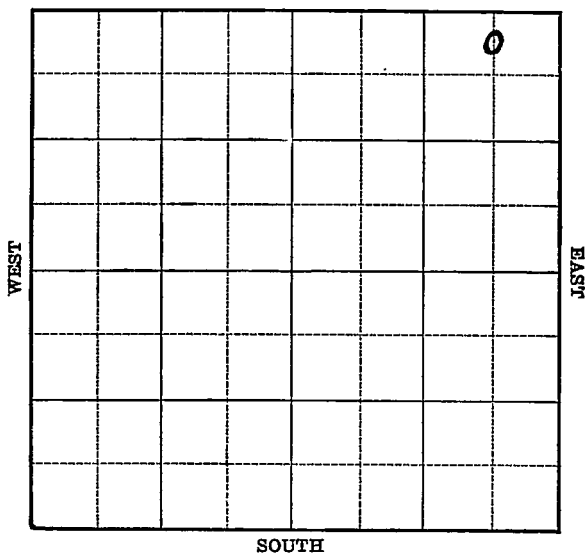

Ellis KANSAS

Map No. 71 Sec. 10 Twp. 12 R. 18WWell No. 1 Oliver

Gulf

Company

Contractor

FIRST REPORT

C N $\frac{1}{2}$ NE NE330 Ft. from N. Line Ft. from S. Line660 Ft. from E. Line Ft. from W. Line

SECTION PLAT

			0

WALTERS POOL

Location Rig up

Drilling and Remarks:

Rotary

RECORD

Cased in., ft.Sand Gas Oil Total Depth

PRODUCTION

1st 24 hrs. Nat. 1st 24 hrs. after shot Gas Cu. Ft.Dry Hole Abandoned

Date

FEB 28 1940


S. J. LEWIS

Scout

Map No. 71 Sec. 10 Twp. 12 R. 18WWell No. 1 OliverGulf

Company

Contractor

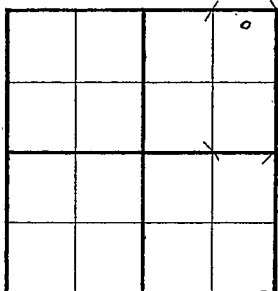COMPLETEDC $N\frac{1}{2}$ NE NE**SECTION PLAT**330 Ft. from N. Line

Ft. from S. Line

660 Ft. from E. Line

Ft. from W. Line

WALTERS POOL

Location _____

Rig up _____

Drilling and Remarks:

*2000 acid**Prod. 384 oil**9.6% water***RECORD**

Cased _____ in. _____ ft.

Sand *turbid 3677 1/2*

Gas _____

Oil _____

Total Depth *3678***PRODUCTION**

1st 24 hrs. Nat. _____

1st 24 hrs. after shot _____

Gas _____ Cu. Ft.

Dry Hole _____

Abandoned _____

Date

APR 10 1940 19S. J. LEWIS Scout