


Section 11 Township 12 Range 17W

Well No. 1 Hall M

Company Cities Service

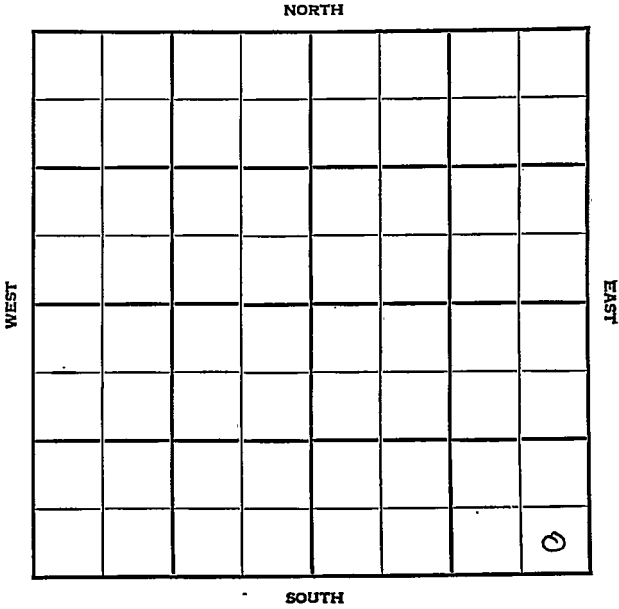

KANSAS

Ellis

Sec. 11 Twp. 12 R. 17-W

Well No. #1 Hall "M" Farm

Cities Service Company

Wildcat


_____ Ft. from N. Line

330' Ft. from S. Line

330' Ft. from E. Line

_____ Ft. from W. Line

SE/C

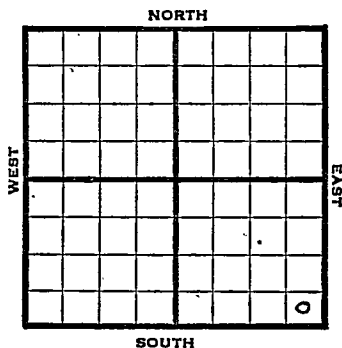

1947

REPORT

12/10	Loc.
12/17	RUR
12/30	8" @ 305' Drlg. 2640'
1948	
1/7	Heebner 3285' Dodge 3306' Lansing 3341' Arbuckle 3656' TD 3690'
1/14	"
1/21	"
2/26	22 shots 3529-3538' 215' oil 15 hrs.
2/4	PB 3562' 1000Acid 24 shots 3506-18' 36 shots 3490-98' 12 shots 3352-56' 12 shots 3361-67' - 700' oil 1 hr. 24 shots 3407-13' 13 shots 3361-67' 2530' oil 12 hrs.
2/11	"
2/18	"
2/25	"

(Over)

1948

3/3 Lansing 3331' (corrected)

3/10 "

3/17 "

3/24 "

3/31 "

4/7 "

4/14 "

4/21 "

4/28 Arb. 3656'

5" @ 3592'

Perf Lans.

Lans. 3341'

5000 Acid

Pump 170 oil & 28% W Pot.

Gr. 300

TD 3690'

COMPLETED

Wildcat

Form 26 200 Bks. 10-46 Petrol
Kansas

Map No. _____ Sec. 11 Twp. 12 R. 17W

Well No. I Hall "M"

Cities Service Company

FIRST REPORT Contractor

SE/C


SECTION PLAT

_____ Ft. from N. Line

330 Ft. from S. Line

330 Ft. from E. Line

_____ Ft. from W. Line

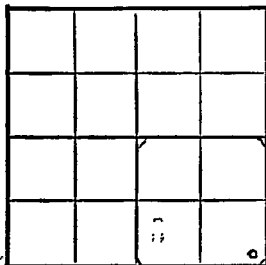

Ellis County

Location X

Rig up _____

Drilling and Remarks:

RECORD

Cased _____ in., _____ ft.

Sand _____

Gas _____

Oil _____

Total Depth _____

PRODUCTION

1st 24 hrs. Nat. _____

1st 24 hrs. after shot _____

Gas _____ Cu. Ft.

Dry Hole _____

Abandoned _____

Date

DEC 10 1947

19

S. J. LEWIS

Scout

Wildcat

Form 26—200 Bks.—1-48—Palace
Kansas

Map No. 71 Sec. 11 Twp. 12 R. 17W

Well No. 1 Hall "M"

Cities Service Company

~~COMPLETED~~ Contractor

SE/C

E1.2090

SECTION PLAT

_____ Ft. from N. Line

330 Ft. from S. Line

330 Ft. from E. Line

_____ Ft. from W. Line

			o

Ellis County

Location _____

Rig up _____

Drilling and Remarks:

Cr 8656

5' 23592

Perf. 4 hrs

4 hrs 3341

5000 acid

Pump 170 rods + 25% oil

Box 30° Se

RECORD

Cased _____ in., _____ ft.

Sand _____

Gas _____

Oil

Total Depth 2690

PRODUCTION

1st 24 hrs. Nat. _____

1st 24 hrs. after shot _____

Gas _____ Cu. Ft.

Dry Hole _____

Abandoned _____

Date

APR 28 1948

19

S. J. LEWIS

Scout