
FORM 51 25M 8-50 WESTERN

Ellis KANSAS

Section 14 Township 12 Range 17W

Well No. #1 Schmidt

Company N C R A & Aylward

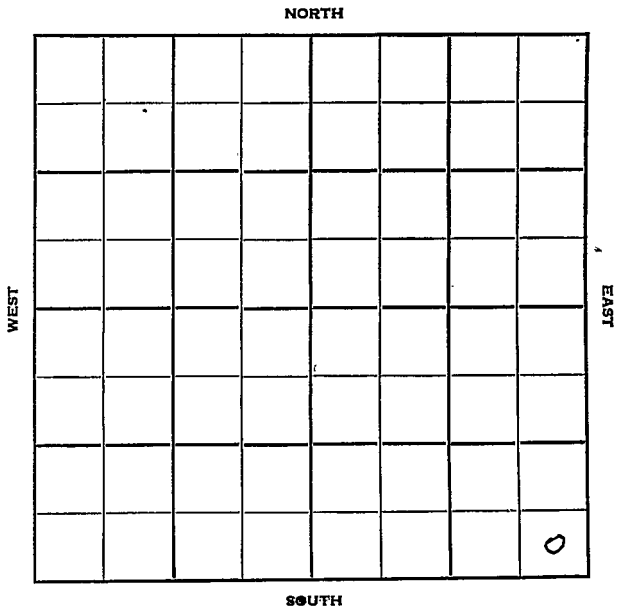

FORM 252-B
10M 11-50 PETROL

Ellis KANSAS

Sec. 14 Twp. 12 R. 17W

Well No. #1 Schmidt Farm

N C R A & Aylward Company

Aylward Drlg. - Contr. Contractor

Wildcat


____ Ft. from N. Line

330' Ft. from S. Line

330' Ft. from E. Line

____ Ft. from W. Line

SE SE SE

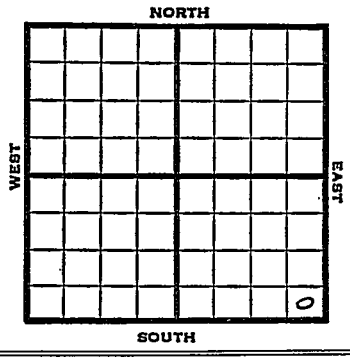

1951	Elev. 2146' REPORT
5/29	Spud 5-27-51 8"@ 120 Drlg. 1115'
6/13	Spud 5-27-51 D & A TD 3823' 8" @ 120 Top 3105' Heeb 3348' Dodge 3374' KC 3397' DST 3559-74 open 1½ hr. rec 90' mud B KC 3636' Cong 3685' Arb. 3791' TD 3823' D & A

ABANDONED

FORM 275 FOR SALE BY KANSAS BLUE PRINT CO.


County Ellis State Kansas

Sec. 14 (Blk. Twp.) 12 (Sur. Rge.) 17W Map No.

Operator N C R A & Aylward

Well No. 1 Farm Schmidt

Elev. Location SE SE SE

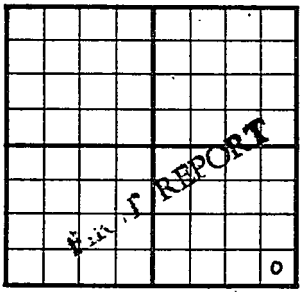

330 Ft. From S Line SE

330 Ft. From E Line Quarter

1st. Report MAY 29 1951

Completion

Remarks Aylward Drlg. & Contr.

Spudding Date 5-27-51

Drlg. Data Wildcat

8" @ 120 drlg. 1115

J. E. TYRA

FORM 275 FOR SALE BY KANSAS BLUE PRINT CO.


County Ellis State Kansas

Sec. 14 (Blk. Twp.) 12 (Sur. Rge.) 17W Map No.

Operator N C R A & Aylward

Well No. 1 Farm Schmidt

Elev. 2146 Location SE SE SE

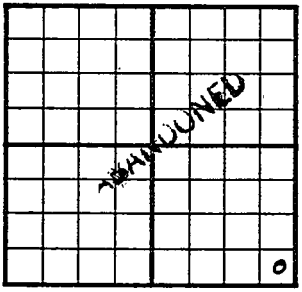

330 Ft. From S Line SE

330 Ft. From E Line Quarter

1st. Report

Completion JUN 13 1951

Remarks Wildcat

Aylward Drlg. - Contr

Spudding Date 5-27-51

Drlg. Data D & A TD 3823

8" @ 120 Top. 3105 Heeb. 3348

Dodge 3374 KC 3397 DST 3559-74

open 1½ hr. Rec. 90' mud

B KC 3636 Cong. 3685 Arb. 3791

TD 3823 D & A

J. E. TYRA