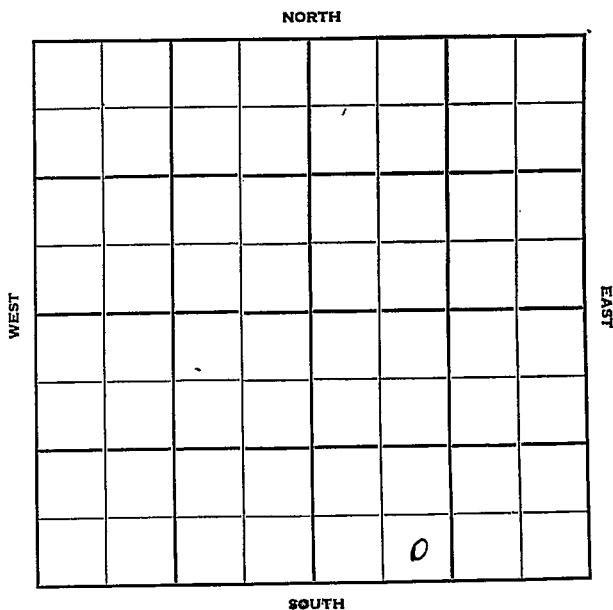


Section 14 Township 12 Range 18 WWell No. # 1 JoyCompany B & R Drilling

Ellis

KANSAS

Sec. 14 Twp. 12 R. 18W

Well No. #1 Joy Farm

B & R Drlg. Company

Contractor

Walters Pool


Ft. from N. Line

330' Ft. from S. Line

Ft. from E. Line

990' Ft. from W. Line

SE SW SE

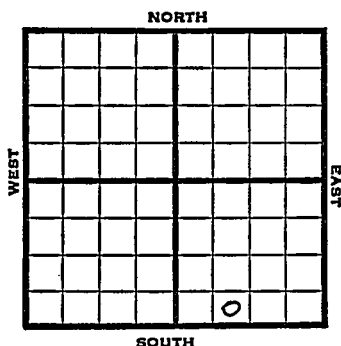

1951

Elev. 2157' REPORT

7/11

Location

8/1

Spud 7-14-51

D & A TD 3763' 8" @ 194


Anhy 1395' Heeb 3373' Lans. 3426'

Cong. 3658' Simp. 3747' Simp.

dol. 3755' Arb. 3759'

TD 3763' D & A

**ABANDONED**

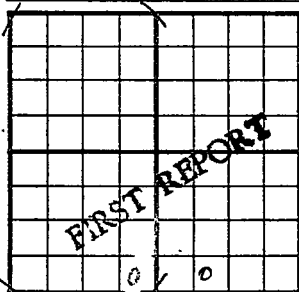
County Ellis State KansasSec. 14 (Blk. 12 (Sur. 18 W Map No.  
Twp.) Rge.)Operator B & R DrillingWell No. 1 Farm JoyElev. Location SE SW SE330 Ft. From S Line SE990 Ft. From W Line Quarter1st. Report JUL 11 1951

Completion

Remarks

Spudding Date

Drlg. Data Walters PoolLocationJ. E. TYRA

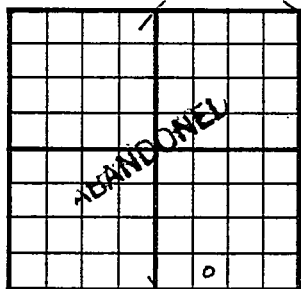County Ellis State KansasSec. 14 (<sup>Blk.</sup>Twp.) 12 (<sup>Sur.</sup>Rge.) 18W Map No.Operator B & R Drlg.Well No. 1 Farm JoyElev. 2157 Location SE SW SE330 Ft. From S Line SE990 Ft. From W Line Quarter

1st. Report

Completion AUG 1 1951Remarks Walters PoolSpudding Date 7-14-51Drlg. Data D & A TD 37638" @ 194 Anhy 1395 Heeb. 3373Lans. 3426 Cong. 3658 Simp. 3747Simp. dol. 3755 Arb. 3759 TD 3763D & A

J. E. TYRA