


# KANSAS

Ellis

Section 14 Township 12S Range 18W

Well No. #1 Joy

Company Harjo Oil & Gas Co.

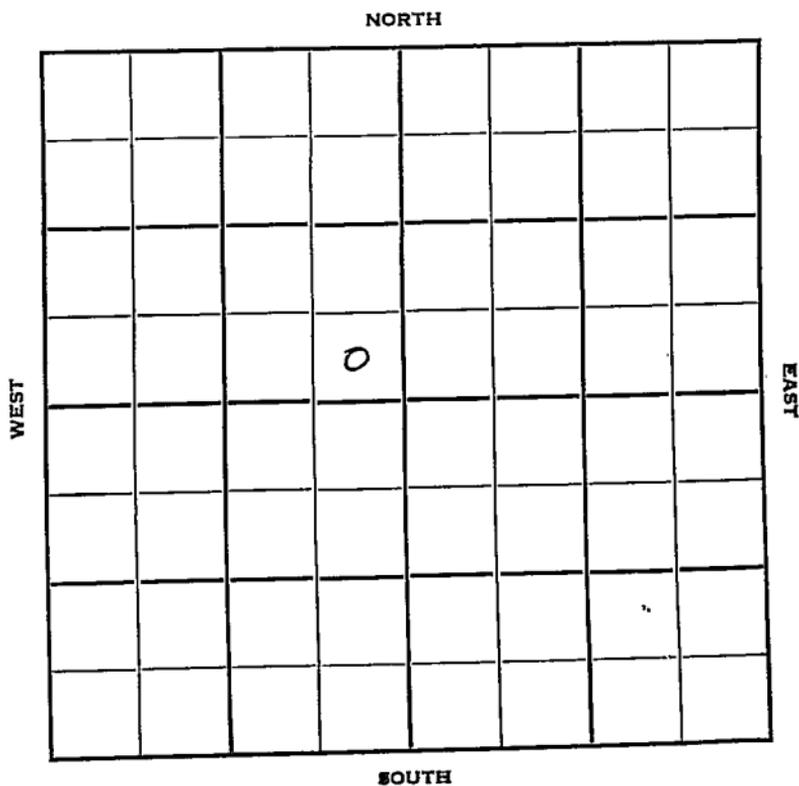

Sec. 14 Twp. 12 R. 18-W

Well No. #1 Joy Farm \_\_\_\_\_

Lario Oil & Gas Company

Cont— Francis


\_\_\_\_\_ Ft. from N. Line

330 Ft. from S. Line

330 Ft. from E. Line

\_\_\_\_\_ Ft. from W. Line

SE NW

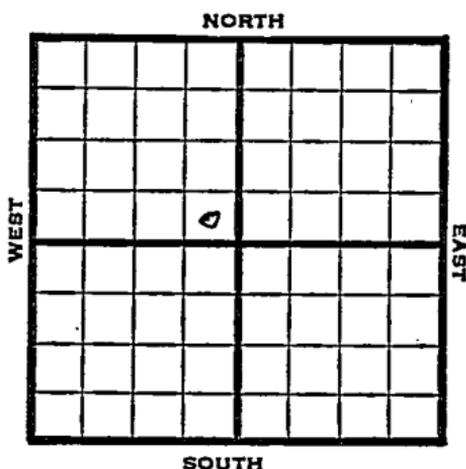

1949	Elv 2149' REPORT
10/5	Anhy 1400'
	8"@ 1410'
10/12	Drlg 2110'
	Arb. 3661-62'
	TD 3662'
	5"@ 3661'
10/19	Lansing 3396'
10/26	"
11/1	TD 3669'
	Pump 47 fluid 71% wtr.
11/9	TD 3669'
	Arb. 3661'
	5"@ 3663'
	Pump 25 Oil / 70% W Pot
	27° Gr.
	Comp
	<b>COMPLETED</b>

Kansas

Map No. \_\_\_\_\_ Sec. 14 Twp. 12 R. 18W

Well No. 1 Joy

Lario Oil & Gas Company

Francis Contractor

SE NW

FIRST REPORT  
SECTION PLAT

\_\_\_\_\_ Ft. from N. Line

330 Ft. from S. Line

330 Ft. from E. Line

\_\_\_\_\_ Ft. from W. Line

		o	

Ell is County

Location \_\_\_\_\_

Rig up \_\_\_\_\_

Drilling and Remarks:

Anhy 1400  
8" @ 1410  
drlg. 2110

RECORD

Cased \_\_\_\_\_ in., \_\_\_\_\_ ft.

Sand \_\_\_\_\_

Gas \_\_\_\_\_

Oil \_\_\_\_\_

Total Depth \_\_\_\_\_

PRODUCTION

1st 24 hrs. Nat. \_\_\_\_\_

1st 24 hrs. after shot \_\_\_\_\_

Gas \_\_\_\_\_ Cu. Ft.

Dry Hole \_\_\_\_\_

Abandoned \_\_\_\_\_

Date

OCT 5 1949 19

S. J. LEWIS Scout

Kansas

Map No. \_\_\_\_\_ Sec. 14 Twp. 12 R. 18W

Well No. 1 Joy

\_\_\_\_\_ Lario Oil & Gas \_\_\_\_\_ Company

**COMPLETE**

Contractor

SE NW

*E. 2149*  
SECTION PLAT

\_\_\_\_\_ Ft. from N. Line

330 Ft. from S. Line

330 Ft. from E. Line

\_\_\_\_\_ Ft. from W. Line

		<i>a</i>	

Ellis County

Location \_\_\_\_\_

Rig up \_\_\_\_\_

Drilling and Remarks:

*Art 3661*

*5" C 3663*

*Pump 25 oil 770 1/2*

*BJ*

*27° SW*

**RECORD**

Cased \_\_\_\_\_ in., \_\_\_\_\_ ft.

Sand \_\_\_\_\_

Gas \_\_\_\_\_

Oil \_\_\_\_\_

Total Depth *2669*

**PRODUCTION**

1st 24 hrs. Nat. \_\_\_\_\_

1st 24 hrs. after shot \_\_\_\_\_

Gas \_\_\_\_\_ Cu. Ft.

Dry Hole \_\_\_\_\_

Abandoned \_\_\_\_\_

Date

NOV 9 1949 19

S. J. LEWIS Scout