


Section 14 Township 12 Range 18-W

Well No. #1 Joy

Company Dolley Oil

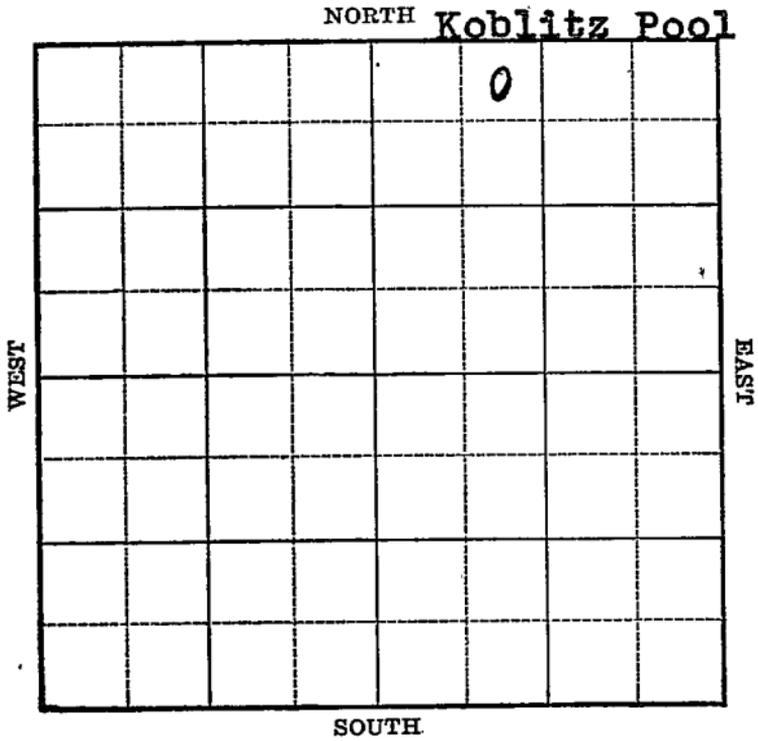

KANSAS

Ellis

Sec. 14 Twp. 12 R. 18-WWell No. #1 Joy FarmDolley Oil Company

(Koblitz)


330 Ft. from N. Line

\_\_\_\_\_ Ft. from S. Line

990 Ft. from E. Line

\_\_\_\_\_ Ft. from W. Line

Elev. 2148

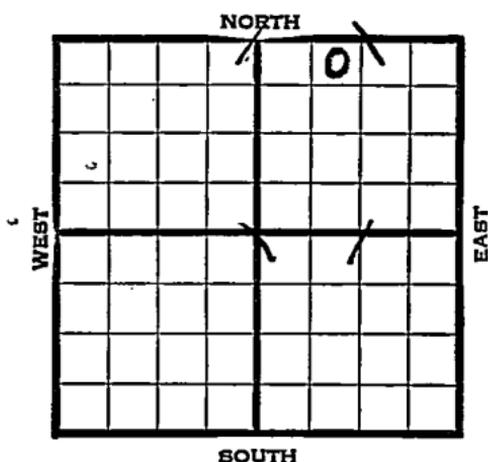

1939	REPORT
7/5	Rotary.
7/13	"
7/20	10" - 128' Drlg. 1750'
7/27	Drlg. 2715'
8/3	Drlg. 3650'
8/10	Topeka 3100' Lans. 3410'
	S.O. 3448-55' S.O. 3480-86'
	Simp. shale. 3656' Arb. 3670'
	S.O. 5" - 3661' T.D. 3676'
	Run 4½" liner to 3672'
8/17	20' of 4" liner at 3672'
	300 acid. Swab 6 bbls. per hour
8/24	T.D. 3676' 1200 acid.
	Pump 7 bbls. per hour.
	Shut down.
8/31	" "
9/7	3000 acid. Pump 16 oil per hour for 5 hours.
9/14	" " "
9/20	" " "
	<b>OVER</b>

1939

9/27

Arb. 3670'

5" - 3661'

T.D. 3676'

4½" liner 3672'

4500 acid.

Pump 51 bbls.

COMPLETED

Map No. \_\_\_\_\_ Sec. 14 Twp. 12 R. 18WWell No. 1 JoyDolley Oil

Company \_\_\_\_\_

Contractor \_\_\_\_\_

## FIRST REPORT

NE NW NE

330 Ft. from N. Line

\_\_\_\_\_ Ft. from S. Line

990 Ft. from E. Line

\_\_\_\_\_ Ft. from W. Line

## SECTION PLAT


## KOBELITZ POOL

Location \_\_\_\_\_

Rig up \_\_\_\_\_

Drilling and Remarks:

Rotary

## RECORD

Cased \_\_\_\_\_ in., \_\_\_\_\_ ft.

Sand \_\_\_\_\_

Gas \_\_\_\_\_

Oil \_\_\_\_\_

Total Depth \_\_\_\_\_

## PRODUCTION

1st 24 hrs. Nat. \_\_\_\_\_

1st 24 hrs. after shot \_\_\_\_\_

Gas \_\_\_\_\_ Cu. Ft.

Dry Hole \_\_\_\_\_

Abandoned \_\_\_\_\_

Date

JUL 5 1939 19

S. I. LEWIS Scout

Ellis

KANSAS

Map No. \_\_\_\_\_ Sec. 14 Twp. 12 R. 18WWell No. 1 JoyDolley Oil

Company \_\_\_\_\_

Contractor \_\_\_\_\_

~~FI COMPLETED~~

NE NW NE

330 Ft. from N. Line

\_\_\_\_\_ Ft. from S. Line

990 Ft. from E. Line

\_\_\_\_\_ Ft. from W. Line

KOBELITZ POOL

## SECTION PLAT

		0	

Location \_\_\_\_\_

Rig up \_\_\_\_\_

Drilling and Remarks:

*Ar 3670**5" @ 3661**4 1/2" liner 3672**4500 acid.**Pump 51886*

## RECORD

Cased \_\_\_\_\_ in., \_\_\_\_\_ ft.

Sand \_\_\_\_\_

Gas \_\_\_\_\_

Oil \_\_\_\_\_

Total Depth 3676

## PRODUCTION

1st 24 hrs. Nat. \_\_\_\_\_

1st 24 hrs. after shot \_\_\_\_\_

Gas \_\_\_\_\_ Cu. Ft.

Dry Hole \_\_\_\_\_

Abandoned \_\_\_\_\_

Date

SEP 27 1939

19

S. J. LEWIS

Scout