


Section 14 Township 12 Range 18-W

Well No. #1 Joy

Company Don Ingling

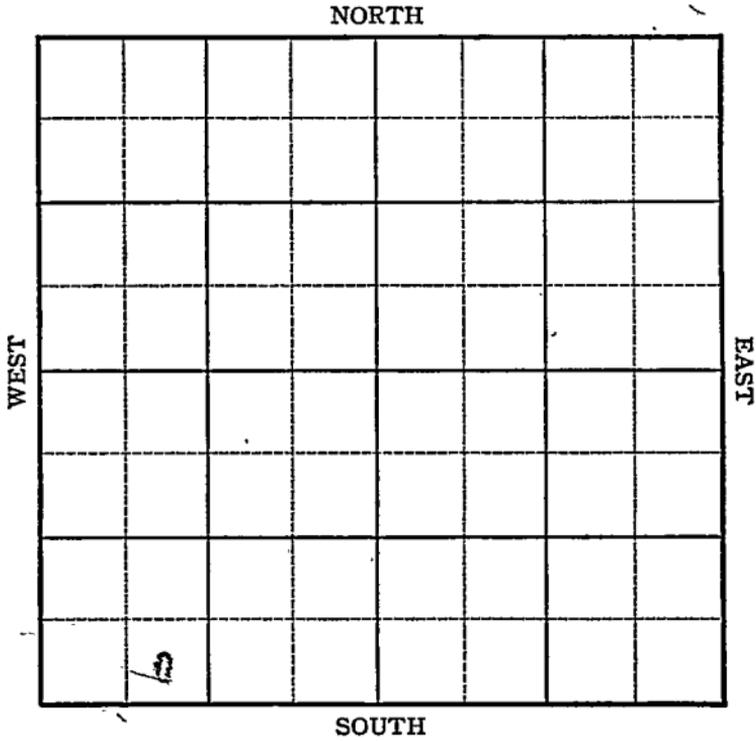

Sec. 14 Twp. 12 R. 18W

Well No. #1 Joy Farm

Don Ingling Company

Glathart


\_\_\_\_\_ Ft. from N. Line

330 Ft. from S. Line

\_\_\_\_\_ Ft. from E. Line

990 Ft. from W. Line

SE SW SW

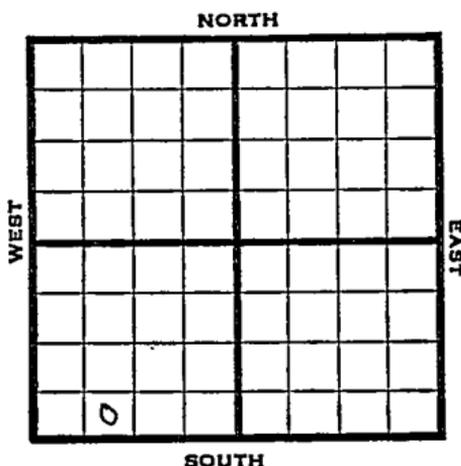

1946 Elev. 2151' REPORT

1/9 Cellar  
 1/17 "  
 1/24 10" - 150' WOC.  
 1/31 Anhy 1407' Drlg. 3060'  
 2/7 Topeka 3120' Drlg. 3155'

2/13 Lans 3416  
 Cong 3665  
 3692' TD in Cong.  
 TD 3692'

ABANDONED



KANSAS

Kansas

Pool Name Glathart

Map No. 71 Sec. 14 Twp. 12 R. 18W

Well No. 1 Joy

Don Ingling Company

**ABANDONED**

SE SW SW

Contractor

*E. 2151*

SECTION PLAT


Ft. from N. Line

330

Ft. from S. Line

Ft. from E. Line

990

Ft. from W. Line

Ellis County

Location \_\_\_\_\_

Rig up \_\_\_\_\_

Drilling and Remarks:

*Lane 3416*  
*Coing 3665*  
*3692 1/2 in Coing*

**RECORD**

Cased \_\_\_\_\_ in., \_\_\_\_\_ ft.

Sand \_\_\_\_\_

Gas \_\_\_\_\_

Oil \_\_\_\_\_

Total Depth 3692

**PRODUCTION**

1st 24 hrs. Nat. \_\_\_\_\_

1st 24 hrs. after shot \_\_\_\_\_

Gas \_\_\_\_\_ Cu. Ft.

Dry Hole \_\_\_\_\_

Abandoned \_\_\_\_\_

Date

FEB 13 1946 19

S. J. LEWIS

Scout