


KANSAS

Ellis

Section 14 Township 12 Range 18-W

Well No. 1 Joy

Company Republic Natural

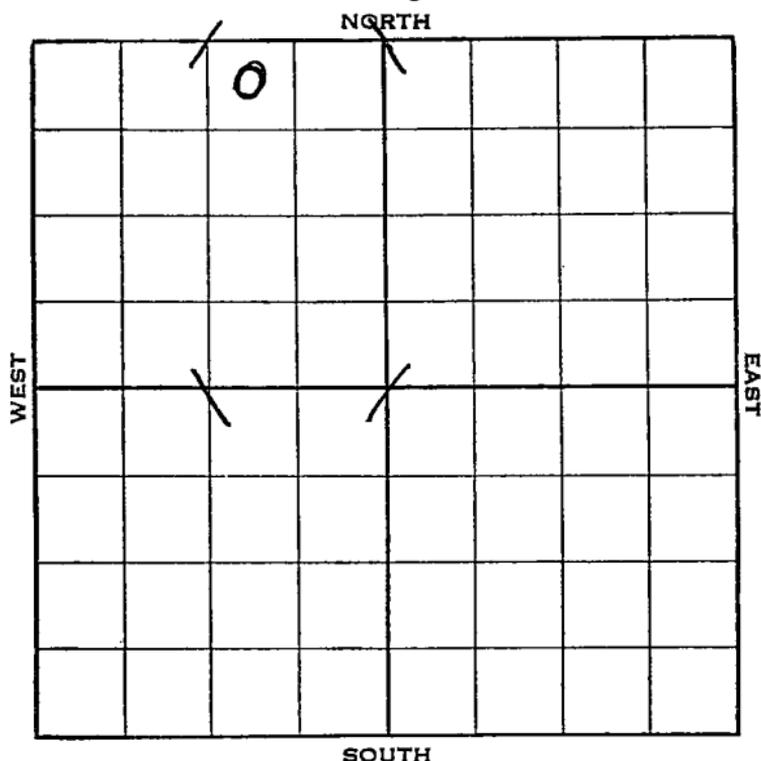

Sec. 14 Twp. 12 R. 18

Well No. #1 Joy Farm

Republic Nat'l. Company


330 Ft. from N. Line

_____ Ft. from S. Line

990 Ft. from E. Line

_____ Ft. from W. Line

Elev. 2148

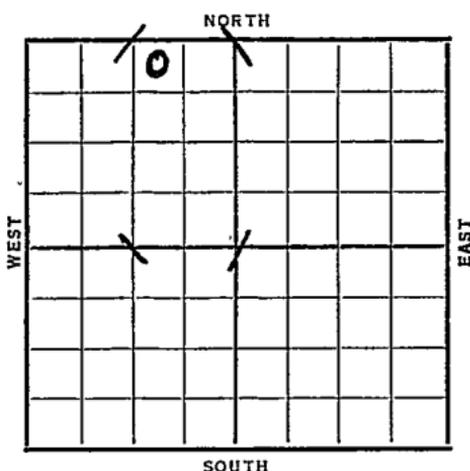

Date

REPORT

1938

3/23

R.R.

4/1

15" @ 88' . Drlg. 1252' .

4/8

Anhy 1388' . 10" @ 1408' .

Drlg. 2210' .

4/15

Topeka 3105' . Drlg. 3245' .

4/22

Dodge 3368' . Lans. 3410' .

S.O. 3441-45' . Simp. 3664' .

Arb. 3682' . T.D. 3688' S.O.

Running 7" .

4/29

7" @ 3682 $\frac{1}{2}$ ' . S.O. 3695' .

T.D. 3695' dry. S.D.O.

5/6

T.D. 3699' S.D.O.

5/12

" " "

5/20

2000 acid. Swab 20 oil per hr. for 8 hrs.

OVER

1938

5/25

7" @ 3682 $\frac{1}{2}$ '.

Arb. 3682'.

T.D. 3699'.

2250 acid.

Potential 936 bbl s.

2 $\frac{1}{2}$ % water.

COMPLETED

Map No. 71 Sec. 14 Twp. 12 R. 18WWell No. I JoyRepublic Natural


Company

Contractor

FIRST REPORT

SECTION PLAT

330 ^{ft.} NW NE NW
Ft. from N. Line
 Ft. from S. Line
990 Ft. from E. Line
 Ft. from W. Line

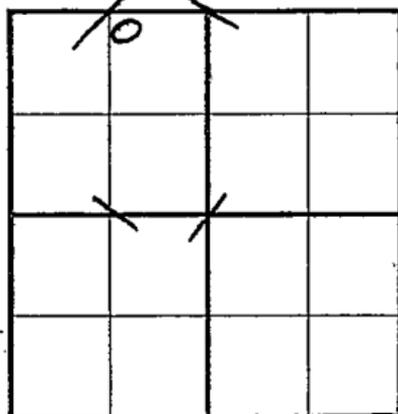Location Rig up

Drilling and Remarks:

RR

RECORD

Cased in., ft.Sand Gas Oil Total Depth

PRODUCTION

1st 24 hrs. Nat. 1st 24 hrs. after shot Gas Cu. Ft.Dry Hole Abandoned

Date

MAR 23 1938

19

H. D. Hatfield Scout

Ellis KANSAS

Map No. 71 Sec. 14 Twp. 12 R. 18W

Well No. #1 Joy

Republic Natural Company

Contractor

COMPLETED

SECTION PLAT

NW NE NW

330 Ft. from N. Line

_____ Ft. from S. Line.

990 Ft. from E. Line

_____ Ft. from W. Line

	0		

Location _____

Rig up _____

Drilling and Remarks:

2250 Acid

Pot 936

2 1/2 70 WTR

RECORD

Cased 7 in., 3682 1/2 ft.

Sand Arb 3682

Gas _____

Oil _____

Total Depth 3699

PRODUCTION

1st 24 hrs. Nat. _____

1st 24 hrs. after shot _____

Gas _____ Cu. Ft.

Dry Hole _____

Abandoned _____

Date

MAY 25 1938 19

H. D. Hatfield Scout