

KANSAS


FORM 51 5M 6-46 PETROL

Ellis county

Section 14 Township 12 Range 18-W

Well No. #1, Joy

Company Ralph Weaver

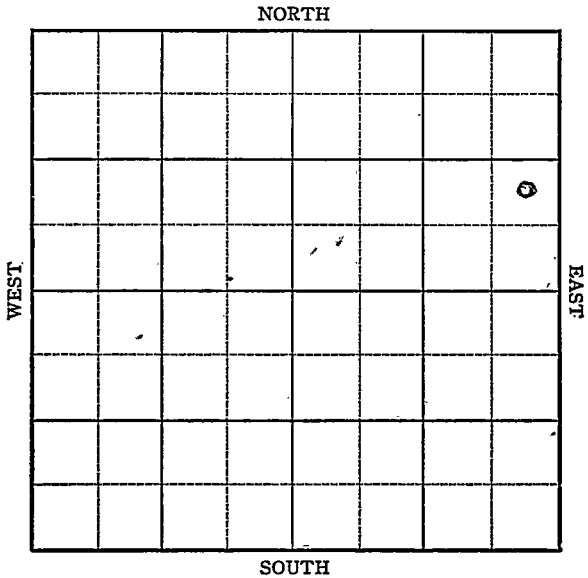

Sec. 14 Twp. 12 R. 18WWell No. 1 Joy FarmRalph Weaver Company

Koblitz Pool

Ft. from N. Line

990


Ft. from S. Line

330

Ft. from E. Line

990

Ft. from W. Line

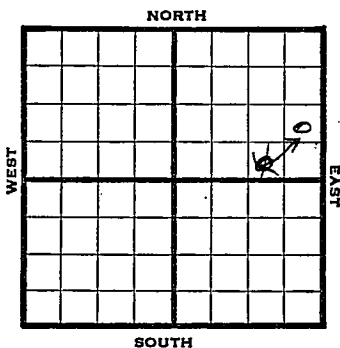

NE SE NE

~~SW SE NE~~

1946 Elev. 2141 REPORT

11/27	8" @ 300'
	Drlg 310'
12/10	Drlg 2013'
12/17	Anhy 1240'
	Drlg 3120'
1947	
1/4	Arb 3653'
	TD 3662'
	5" @ 3653, RUST
1/8	Swb 5 oil 1 hr
1/15	1000 Acid
	Swb 12 oil per hr for 6 hrs
1/21	" "
1/30	" "
2/5	" "
2/12	" "
2/19	" "
2/26	" "

OVER

3/5

Arb 3653

5" @ 3653

1000 Acid

Pump 278 Pot

Grav. 27

TD 3662'

COMPLETED

Map No. 71 Sec. 14 Twp. 12 R. 18W

Well No. 1 Joy

Ralph Weaver Company

FIRST REPORT Contractor

SW SE NE

SECTION PLAT

 Ft. from N. Line

330 Ft. from S. Line

990 Ft. from E. Line

 Ft. from W. Line

			2

Ellis County

Location

Rig up

Drilling and Remarks:

8" @ 300

drlg. 310

RECORD

Cased in. ft.

Sand

Gas

Oil

Total Depth

PRODUCTION

1st 24 hrs. Nat.

1st 24 hrs. after shot

Gas Cu. Ft.

Dry Hole

Abandoned

Date

NOV 27 1946

19

S. J. LEWIS

Scout

Kansas

Map No. 71 Sec. 14 Twp. 12 R. 18WWell No. 1 Joy

Ralph Weaver


Company

CORRECTION

Contractor

NE SE NE

SECTION PLAT

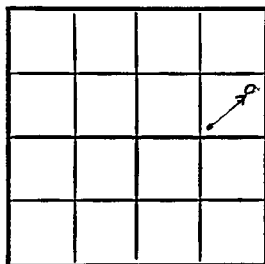 Ft. from N. Line990 Ft. from S. Line330 Ft. from E. Line Ft. from W. Line

Ellis County

Location Rig up

Drilling and Remarks:

Reported

SW SE NE

RECORD

Cased in. ft.Sand Gas Oil Total Depth

PRODUCTION

1st 24 hrs. Nat. 1st 24 hrs. after shot Gas Cu. Ft.Dry Hole Abandoned

Date

DEC 4 1946

19

S. J. LEWIS

Scout

