

KANSAS


Ellis

FORM 51 IOM 12-46 PETROL

Section 14 Township 12 Range 18W

Well No. 2 Joy

Company Biddle Drig

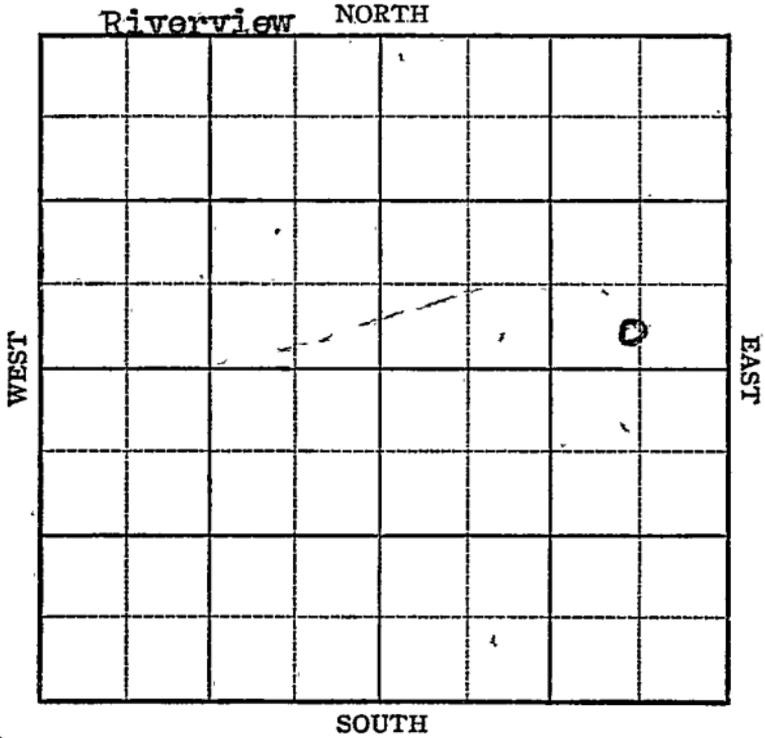

Sec. 14 Twp. 12 R. 18W

Well No. #2 Joy Farm

Biddle Drlg. Company


Riverview

 Ft. from N. Line

330 Ft. from S. Line

660 Ft. from E. Line

 Ft. from W. Line

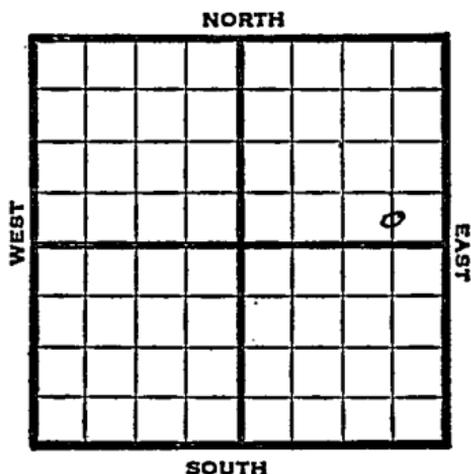

C S L SE NE

1947 Elev. 2145' REPORT

8/6 10" @ 98'
Anhy. 1390'
Drlg. 1425'

8/13 Drlg. 3179'

8/20 Arbuckle 3609'
TD 3652
5" @ 3650
RUST.

8/27 TD 3656'
1000 acid
Swb 10 bbls. oil PH, 12 hrs.

9/3 "

9/10 Arb. 3609'
5" @ 3650'
1000 acid
Pump 306 Pot
35.0 Gr.
TD 3656'

COMPLETED

Map No. _____ Sec. 14 _____ Twp. 12 _____ R. 18W

Well No. 2 Joy _____

_____ Biddle Drlg. _____ Company

FIRST REPORT

_____ Contractor

C S L SE NE

SECTION PLAT

_____ Ft. from N. Line

330 _____ Ft. from S. Line

660 _____ Ft. from E. Line

_____ Ft. from W. Line

			o

Ellis County

Location _____

Rig up _____

Drilling and Remarks:

10" @ 98'

Anhy 1390'

1425'

RECORD

Cased _____ in., _____ ft.

Sand _____

Gas _____

Oil _____

Total Depth _____

PRODUCTION

1st 24 hrs. Nat. _____

1st 24 hrs. after shot _____

Gas _____ Cu. Ft.

Dry Hole _____

Abandoned _____

Date

AUG 6 1947 19

S. J. LEWIS

Scout

