


DX 78-1

Ellis **KANSAS**

Section 14 Township 12 Range 18W

Well No. #3 Joy "A"

Company Lario Oil & Gas

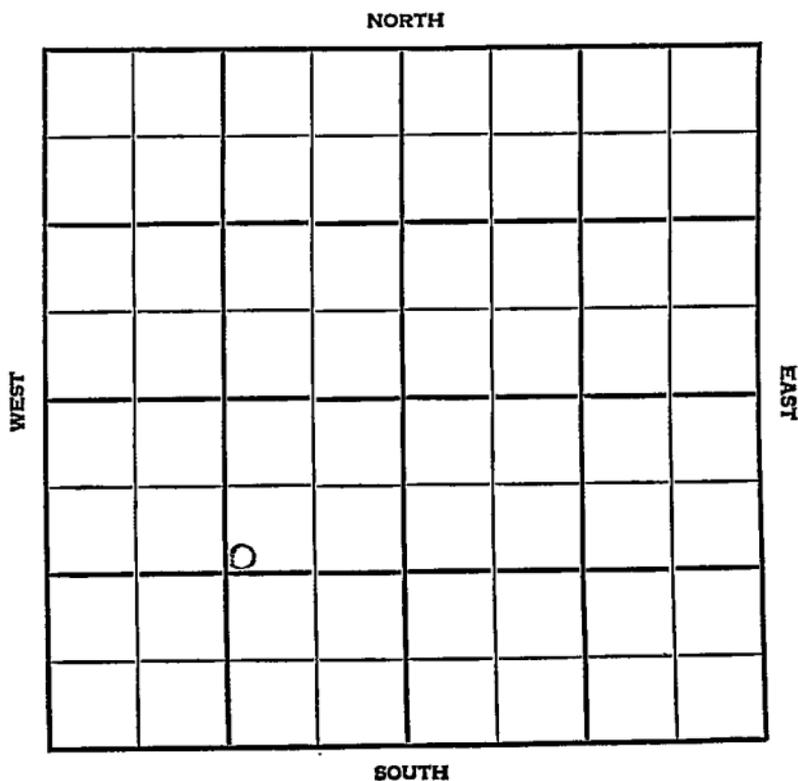

Ellis

KANSAS


SEC.	TWP.	R.
14	12	18W

WELL NO. **3 Joy "A"** FARM

COMPANY **Lario Oil & Gas**

CONTRACTOR **Sterling Drlg.**

\_\_\_\_\_ Ft. from N. Line  
 \_\_\_\_\_ Ft. from S. Line  
 \_\_\_\_\_ Ft. from E. Line  
 \_\_\_\_\_ Ft. from W. Line

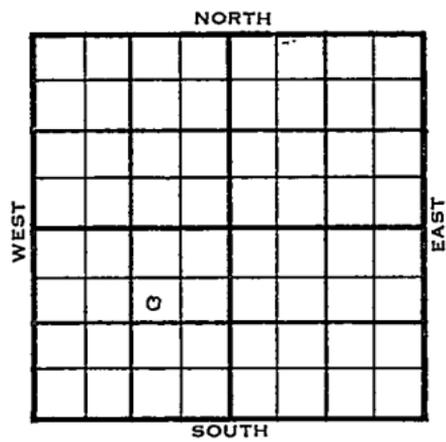

SW NE SW

1955	ELEVATION	REPORT																		
5/26	Comm 5-13-55 8" @ 202 w/135 Drlg 2075 DST 3643-48, open 1 hr. Rec. 2495' oil 1100/15" 5 1/2" @3643/100 CO to 3648 S/1 1/2 boph 4 hr. 250 A Comp. 25 bopd.																			
	<table border="0"> <tr> <td>Tops;</td> <td>Depth</td> <td>Datum</td> </tr> <tr> <td>H.</td> <td>3324</td> <td>1189</td> </tr> <tr> <td>L.</td> <td>3370</td> <td>1235</td> </tr> <tr> <td>S.</td> <td>3629</td> <td>3492</td> </tr> <tr> <td>A.</td> <td>3642</td> <td>1507</td> </tr> <tr> <td>TD.</td> <td>3648</td> <td></td> </tr>
	COMPLETED																			

Top Pool

Co. Face

FORM 513 REV. SUNRAY

# FIRST REPORT

County Ellis Elevation 18W  
 Sec. 14 Twp. (12) Rge. 18W  
 Company Lario Oil & Gas  
 Farm Name Joy "A" No. 3

Co.

TOPS	DEPTH	LOG	DATUM
Anh.			
Ip.			
H.			
Tr.			
Dg.			
Bl.			
L.			
K.C.			
B.K.C.			
Ce.			
C.			
M.			
M.			
K.			
Mz.			
Ma.			
V.			
S.			
S.			
A.			
R.			
PE.			
G.			
T.D.			

Loc. in Sec. SW NE SW

Geol. \_\_\_\_\_

Contr. \_\_\_\_\_

Sterling Drlg

Pool \_\_\_\_\_



Use

No.

Sec.

T.

R.

Date Comm. 5-13-55

8" @ 202 w/ 135 drlg. 2075

County Ellis Elev. 2135  
 Sec. 14 Twp. 12 Rge. 18W  
 Company Iario Oil & Gas  
 Farm Name Joy "A" No. 3

TOPS	DEPTH	LOG	DATUM
Anb.			
TP.			
H.	<u>3324</u>		<u>1189</u>
Tr.			
Dg.			
BL.			
L.	<u>3370</u>		<u>1235</u>
K.C.			
B.K.C.			
Ce.			
C.			
M.			
M.			
K.			
Mz.			
Me.			
V.			
S.	<u>3629</u>		<u>1492</u>
S.			
A	<u>3642</u>		<u>1507</u>
R.			
PE.			
G.			
TD.	<u>3648</u>		

Loc. in Sec. SW NE SW  
 Geol. \_\_\_\_\_  
 Contr. \_\_\_\_\_  
 Sterling  
 Pool \_\_\_\_\_

<b>COMPLETE</b>			

Date Comm. 5-13-55 JUN 15 1955  
 8" @ 202/135 DST 3643-48 open 1 hr.  
 Rec. 2495' oil 1100/15" 5 1/2" @ 3643/100  
 OO to 3648 S/ 1 1/2 boph 4 hr. 250 A  
 Comp. 25 bopd

Co.  
 Lse.  
 No.  
 Sec.  
 T.  
 R.