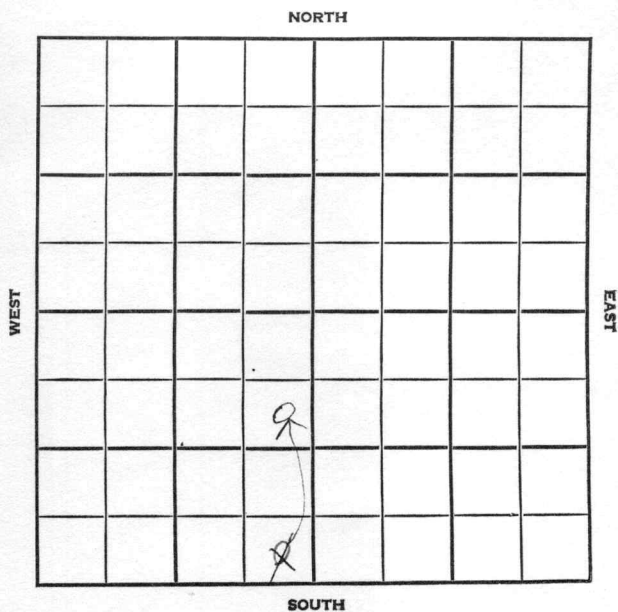


Section 14 Township 12 Range 18WWell No. #4 JoyCompany Lario Oil & Gas

SEC.	TWP.	R.
14	12	18W

WELL NO.

#4 Joy

FARM

COMPANY

Lario Oil & Gas

CONTRACTOR


Walters

FT. FROM N. LINE

FT. FROM S. LINE

FT. FROM E. LINE

FT. FROM W. LINE

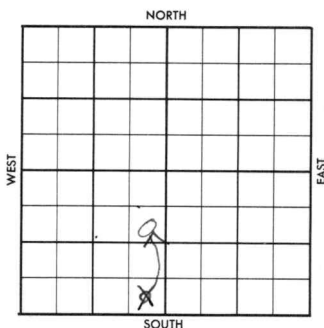

SE ~~SE~~ SW
NE

ELEVATION

REPORT

1956

2139'

6-27

Location

7-18

Spud 6-28-56
10 3/4" @ 200 w/150
DST 3476-87 op 1 hr, rec. 15' SOCM
BHP 450/20".
DST 3650-55 op 1 hr, rec. 520' oil /
90' mdy oil, BHP 950/20".
7" @ 3650
CO 3655
FU 1200' oil, 4 hrs.,
S/ 8 BOPH, no/wtr., 500' O.B.
B/ 50 BOPD, no/wtr.
H. 3334'; Tr. 3354'; L. 3378';
A. 3648';
TD 3655'


COMPLETED

County Ellis Elev. _____ Co. _____
 Sec. 14 Twp. 12 Rge. 18W
 Company Lario Oil & Gas
 Farm Name Joy No. 4

TOPS	DEPTH	LOG	DATUM	Loc. in Sec.
Anh.				SE SE SW
Tr.				
H.				
Tr.				
Dg.				
Bl.				
L.				Geol.
K.C.				Contr.
B.K.C.				
Ce.				
C.				
M.				
M.				Pool
K.				Walters
Mz.				
Me.				
V.				
S.				
S.				
A.				FIRST REPORT
R.				JUN 27 '56
P.				
G.				
T.D.				0

Date Comm.

Location

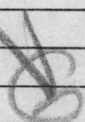

422

CORRECTION

FORM 513 SUNRAY

Co.

County Elm Elev. 2159
 Sec. 14 Twp. 18 Rge. 18W
 Company Lario Oil & Gas
 FarmName Joy No. 4

TOPS	DEPTH	LOG	DATUM	Loc. in Sec.
Anh.				SE SE SW NE
Tp.				
H.	3334			
Tr.	3354			
Dg.				
BL.				
L.	3378			
K.C.				Geol.
B.K.C.				Contr.
Ce.				
C.				
M.				
M.				Pool
K.				Walters
Mz.				
Me.				
V.				
S.				
S.				
A	3648			
R.				
PE.				
G.				
TD	3655			

Loc.

No.

Sec.

T.

R.

Date Comm.

Location JUL 3 '56 6-28-56 10 3/4
 200/150 1740 JUL 11 '56
 DST 3476-87 1hr. rec 15' 50cm
 BHP 450/20" DST 3650-55 1hr.
 rec 520' oil + 90° Mdy oil BHP
 950/20" 7" @ 3650 JUL 18 '56 co
 3655 FU 1200' oil 4hrs & 8
 Boph no/wtr 500' O.B P. 50
 Bopd no/wtr.