


Section 14 Township 12 Range 18WWell No. #1 Joy "A"Company K. & E. Drlg.

NORTH

WEST

EAST

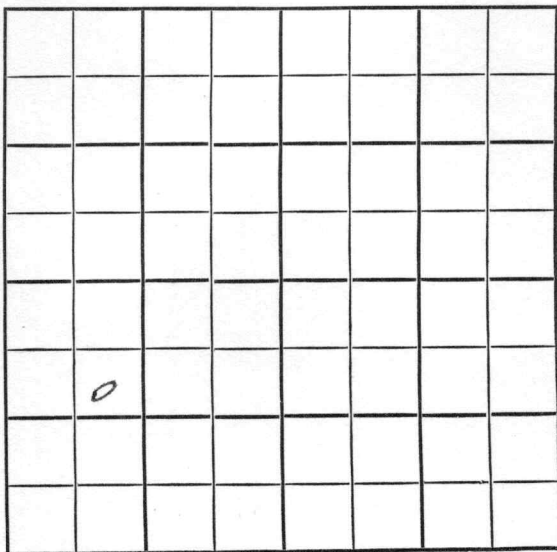

SOUTH

Ellis

KANSAS

SEC.	TWP.	R.
14	12	18 W

WELL NO.

1 Joy "A"

FARM

COMPANY

K & E Drlg.

CONTRACTOR


Walters

Ft. from N. Line

Ft. from S. Line

Ft. from E. Line

Ft. from W. Line

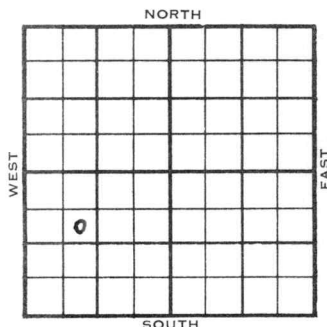

SE NW SW

1955

ELEVATION

2142'

REPORT

6/15

Comm. 5-2-55

8" @ 180/135

DST 3647-53 open $\frac{1}{2}$ hr rec 2230' oil

1060# 5" @ 3647 CO to 3653

FU 2500' oil P/6 BOPH

Comp. 25 BOPD

Anh 1380', Tp 3114', H. 3333'

L. 3377', A. 3645'

ED 3653'

FIRST REPORT
COMPLETED

County Ellis Elev. 2142
 Sec. 14 Twp. 12 Rge. 18W
 Company K & E Drilg.
 Farm Name Joy "A" No. 1

TOPS	DEPTH	LOG	DATUM	Loc. in Sec.
Anh.	1380			SE NW SW
Tp.	3114		972	
H.	3333		1791	
Tr.				
Dg.				Geol.
Bl.				
L.	3377		1235	Contr.
K.C.				
B.K.C.				Pool
Ce.				
C.				Walters
M.				
M.				FIRST REPORT COMPLETE
K.				
Mz.				
Me.				
V.				
S.				
S.				
A	3645		1503	
R.				
Pc.				
G.				
T.D.	3653			

Date Comm. 5-2-55 JUN 15 1955

8" @ 180/135 DST 3647-53 open $\frac{1}{2}$ hr.

Rec. 2230' oil 1060# 5" @ 3647

CO to 3653 FU 2500' oil P/ 6 bopd

Comp. 25 bopd