


Section 14 Township 12 Range 18W

Well No. 2 Joy B

Company Biddle Dlg. etal

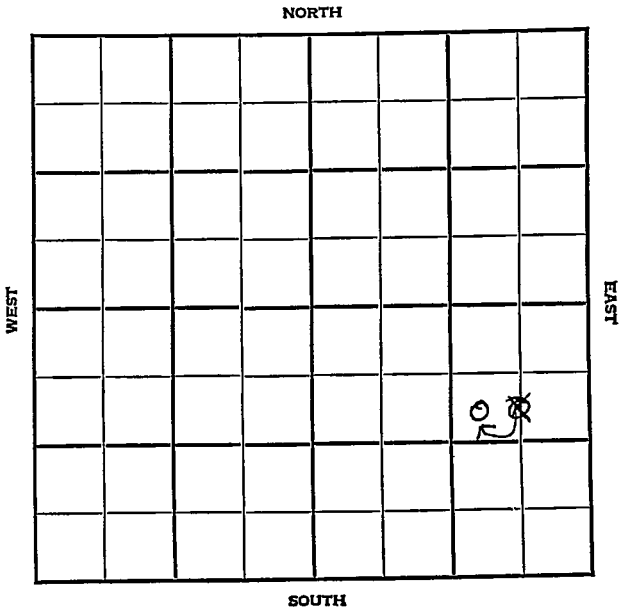

KANSAS Ellis

Sec. 14 Twp. 12 R. 18W

Well No. #2 Joy "B" Farm

Biddle Drlg. et al Company

Walters


990 Ft. from N. Line

 Ft. from S. Line

990'
660 Ft. from E. Line

 Ft. from W. Line

~~SW NE SE~~
~~G SL NE SE~~

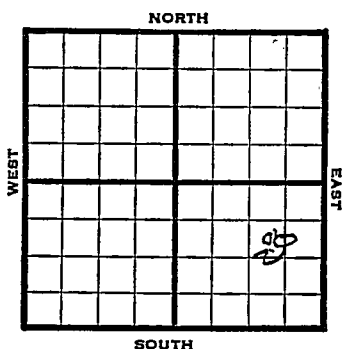

1947 Elev. 2142' REPORT

12/17	Surface hole.
12/30	8" @ 160' Anhy. 375' Drlg. 3475'
1948 1/7	5" @ 3681'
1/14	Arbuckle 3678' TD 3683' 5" @ 3678' 1000 acid swb 100 bls oil 6 hrs
1/21	"
2/26	"
2/4	Arb. 3678' 5" @ 3678' 1000 acid Pump 243 oil pot Gr. 24.0 TD 3683' Comp.

COMPLETED

Map No. _____ Sec. 14 Twp. 12 R. 18W

Well No. 2 Joy "B"

Biddle Drlg. etal. Company

FIRST REPORT Contractor

C S L NE SE

SECTION PLAT

990 Ft. from N. Line

_____ Ft. from S. Line

660 Ft. from E. Line

_____ Ft. from W. Line

			6

Ellis County

Location _____

Rig up _____

Drilling and Remarks:

surface hole

RECORD

Cased _____ in., _____ ft.

Sand _____

Gas _____

Oil _____

Total Depth _____

PRODUCTION

1st 24 hrs. Nat. _____

1st 24 hrs. after shot _____

Gas _____ Cu. Ft.

Dry Hole _____

Abandoned _____

Date

DEC 17 1947 19

S. J. LEWIS Scout

Map No. 71 Sec. 14 Twp. 12 R. 18WWell No. 2 Joy "B"Biddle Drlg. etal.

Company

CORRECTION

Contractor

SW NE SE

SECTION PLAT

990 Ft. from N. Line Ft. from S. Line990 Ft. from E. Line Ft. from W. Line

			0

Ellis CountyLocation Rig up

Drilling and Remarks:

Corrected from
C S L NE SE

RECORD

Cased in., ft.Sand Gas Oil Total Depth

PRODUCTION

1st 24 hrs. Nat. 1st 24 hrs. after shot Gas Cu. Ft.Dry Hole Abandoned

Date

DEC 24 1947 19S. J. LEWIS

Scout

Map No. 7/ Sec. 14 Twp. 12 R. 18W

Well No. 2 Joy "B"

Biddle Drlg. etal. Company

COMPLETE

Contractor

SW NE SE


F1.2/42
SECTION PLAT

990 Ft. from N. Line

 Ft. from S. Line

990 Ft. from E. Line

 Ft. from W. Line

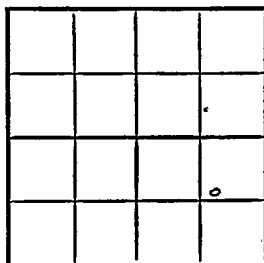

Ellis County

Location

Rig up

Drilling and Remarks:

Cr 43678

5' 03678

1000 acd

Pump 243 oil

PS

24-32

RECORD

Cased in., ft.

Sand

Gas

Oil ✓

Total Depth 8683

PRODUCTION

1st 24 hrs. Nat.

1st 24 hrs. after shot

Gas Cu. Ft.

Dry Hole

Abandoned

Date

FEB 4 1948 19

S. J. LEWIS Scout