

KANSAS

Form 51--5M--7-39--Palace


Ellis

Section 14 Township 12 Range 18-W

Well No. #2 Joy "B"

Company Republis Nat. Gas.

NORTH Walters Arb.Pool

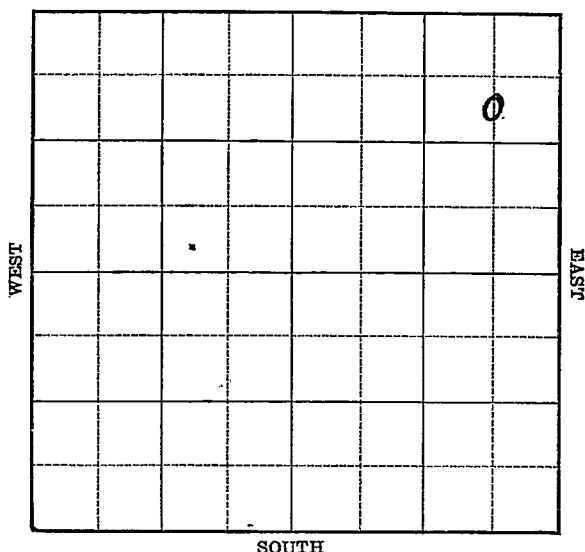

1940

3/27

Arb. 3633 $\frac{1}{2}$ '

5 $\frac{1}{2}$ " - 3635'

T.D. 3645'

4000 acid.

Depthograph potential 2949 bbls.

COMPLETED

Map No. 71 Sec. 14 Twp. 12 R. 18WWell No. 2 JoyRepublic Nat. Gas

Company

Contractor

FIRST REPORT

SECTION PLAT

990 C S $\frac{1}{2}$ NE NE
Ft. from N. Line Ft. from S. Line660 Ft. from E. Line Ft. from W. Line

			e

WALTERS ARB. POOL

Location Rig up

Drilling and Remarks:

Rotary

RECORD

Cased in., ft.Sand Gas Oil Total Depth

PRODUCTION

1st 24 hrs. Nat. 1st 24 hrs. after shot Gas Cu. Ft.Dry Hole Abandoned

Date

DEC 20 1939

19

S. J. LEWIS

Scout

E. is

KANSAS

Map No. 71 Sec. 14 Twp. 12 R. 18WWell No. 2 Joy "B"Republic Natural Gas

Company

CORRECTION

Contractor

SECTION PLAT

C S $\frac{1}{2}$ NE NE990 Ft. from N. Line Ft. from S. Line660 Ft. from E. Line Ft. from W. Line

WALTERS ARB. POOL

			o

Location

RECORD

Cased in., ft.Sand Gas Oil Total Depth Rig up

Drilling and Remarks:

Reported as

#2 Joy

PRODUCTION

1st 24 hrs. Nat. 1st 24 hrs. after shot Gas Cu. Ft.Dry Hole Abandoned

Date

JAN 2 1941 19

S. J. LEWIS

Scout

Ellis

KANSAS

Map No. 71 Sec. 14 Twp. 12 R. 18WWell No. 2 Joy "B"Republic Natural Gas Company

Contractor

COMPLETED

SECTION PLAT

990 C S $\frac{1}{2}$ NE NE
Ft. from N. Line

Ft. from S. Line

660 Ft. from E. Line

Ft. from W. Line

WALTERS ARB. POOL

			o

Location

RECORD

Rig up

Cased _____ in., _____ ft.

Drilling and Remarks:

Sand _____

at 3633 1/2

Gas _____

5 1/2' @ 3635

Oil _____

*4000 Acid*Total Depth *3645**Dep. lograph P & Y*

PRODUCTION

2949

1st 24 hrs. Nat. _____

1st 24 hrs. after shot _____

Gas _____ Cu. Ft.

Dry Hole _____

Abandoned _____

Date

MAR 27 1940

19

S. J. LEWIS Scout