

Sec. 14 Twp. 12 R. 18W

Well No. ~~#2~~ #2 Joy "G" Farm

Petroleum, Inc. Company

Garvey - Contr. Contractor


Ft. from N. Line.

330' Ft. from S. Line

990' Ft. from E. Line

Ft. from W. Line

SW SE SW

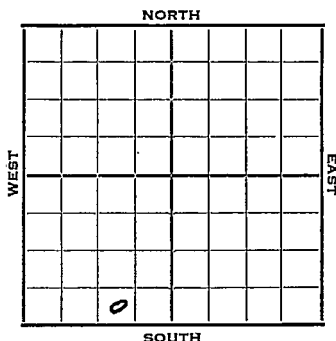

1952 Elev. 2139' REPORT

6/4 Spud 5-29-52
8" @ 202
Anhy 1382
Drlg. 2155'

6/11 Drlg. 3704'

6/18 Heeb 3342' Lans. 3389' Arb. 3650'
RTD 3700' 5" @ 3699 16/3658-62 SO
16/3668-72 SSO 16/3668-72
2 1/2 gal OPH 1500 A 1 BOPH

6/25 Spud 5-29-52
D&A TD 3700' 8" @ 202'
Anhy 1382 Heeb. 3342
Lans. 3389 Arb. 3650
TD 3700 5" @ 3699 16/ 3658-62
16/ 3668-72 16/ 3668-72
2 goph 40/ 3658-72 2 1/2 goph 1500 A
1 boph 20 bopd 17 1/4 bw
Perf/ 3678-82 250 A oil. dec.
D&A

ABANDONED

Map No. _____ Sec. 14 Twp. 12 R. 18W

Well No. 2 Joy "C"

_____ Petroleum Inc. _____ Company

_____ CORRECTION _____ Contractor

SW SE SW

SECTION PLAT

_____ Ft. from N. Line

330 Ft. from S. Line

990 Ft. from E. Line

_____ Ft. from W. Line

Ellis County

Location _____

Rig up _____

Drilling and Remarks:

Reported

#3 Joy "C"

RECORD

Cased _____ in., _____ ft.

Sand _____

Gas _____

Oil _____

Total Depth _____

PRODUCTION

1st 24 hrs. Nat. _____

1st 24 hrs. after shot _____

Gas _____ Cu. Ft.

Dry Hole _____

Abandoned _____

Date

JUN 4 1952

J. G. McGEHEE

Scout

