

KANSAS

Ellis


Section 14 Township 12 Range 18W

Well No. 3 Joy "C"

Company Shawver-Graham

Walter

NORTH

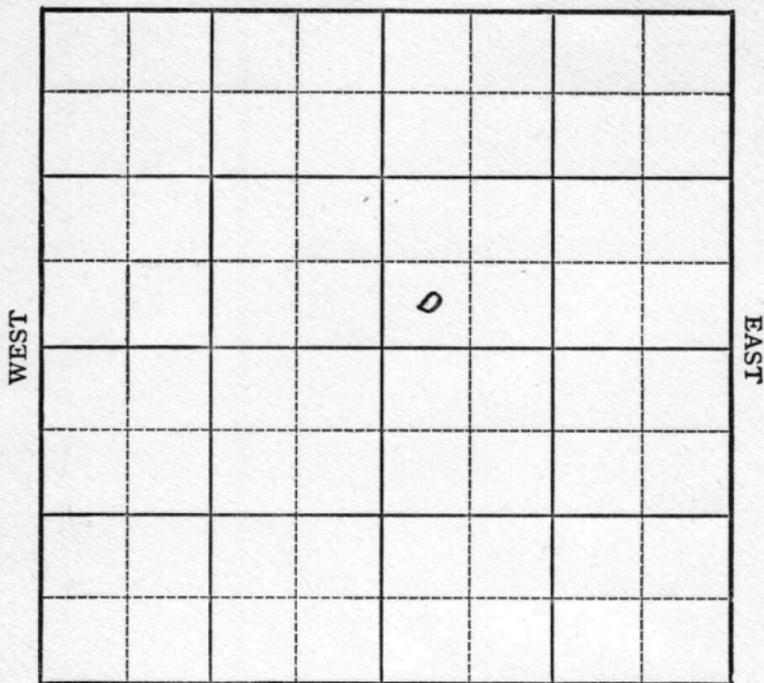

SOUTH

KANSAS


Ellis

Sec. 14 Twp. 12 R. 18W ✓

Well No. #3 Joy "C" Farm

Shawver - Graham Company
(Shawver - Graham, Cont.)

_____ Ft. from N. Line
330' Ft. from S. Line
_____ Ft. from E. Line
330' Ft. from W. Line

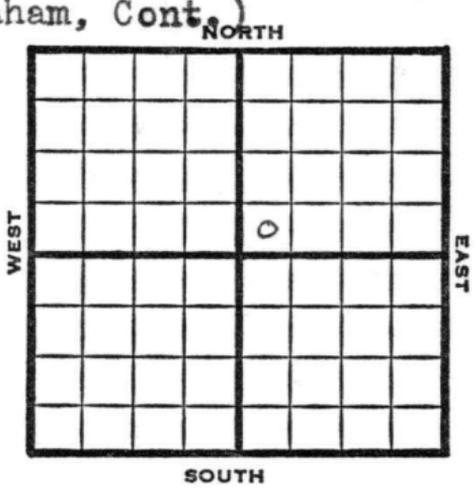

SW NE

1949 Elev 2153' REPORT

6/1 8" @165'
Anhy 1378'
Drlg. 2733'

6/7 Drlg. 3395'

6/15 Lansing 3398'
Arb. 3662'-65'
TD 3665'
5" @ 3664'

6/21 TD 3671'
3000 acid

6/28 TD 3675
1250 acid
Swb 40 bbls oil a day

7/6 "

7/13 TD 3675'
Arb. 3662'
5" @ 3664'
Pump 107 Oil / 1% W Pot
27° Gr.
Comp

COMPLETED

Map No. _____ Sec. 14 Twp. 12 R. 18W

Well No. 3 Joy "C"

Shawver - Graham Company

Shawver - Graham Contractor

SW NE

FIRST SECTION PLAT

_____ Ft. from N. Line

330 Ft. from S. Line

_____ Ft. from E. Line

330 Ft. from W. Line

Ellis County

Location _____

Rig up _____

Drilling and Remarks:

8" @ 165

Anhy 1378

drlg. 2733

RECORD

Cased _____ in., _____ ft.

Sand _____

Gas _____

Oil _____

Total Depth _____

PRODUCTION

1st 24 hrs. Nat. _____

1st 24 hrs. after shot _____

Gas _____ Cu. Ft.

Dry Hole _____

Abandoned _____

Date

JUN 1 1949 19

S. J. LEWIS Scout

Kansas

Map No. K71 Sec. 14 Twp. 12 R. 18W

Well No. 3 Joy "C"

Shawver - Graham Company

COMPLETE

Contractor

SW NE

E1.2153

SECTION PLAT

_____ Ft. from N. Line

330 Ft. from S. Line

_____ Ft. from E. Line

330 Ft. from W. Line

Ellis County

Location _____

Rig up _____

Drilling and Remarks:

*cut 3662
5" C 3664.*

*Pump 107 oil 7 1/2"
P.S.Y.*

27° 4'

RECORD

Cased _____ in., _____ ft.

Sand _____

Gas _____

Oil _____

Total Depth 8625

PRODUCTION

1st 24 hrs. Nat. _____

1st 24 hrs. after shot _____

Gas _____ Cu. Ft.

Dry Hole _____

Abandoned _____

Date

JUL 13 1949

19

S. J. LEWIS

Scout