

DX 78-1


Ellis

KANSAS

Section 14 Township 12 Range 18W

Well No. #3 Joy "C"

Company Petroleum Inc.

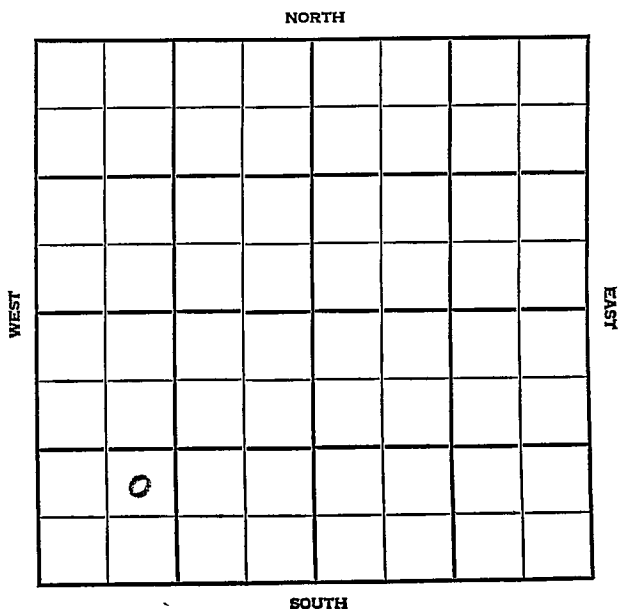

Ellis

KANSAS

SEC.	TWP.	R.
14	12	18W

WELL NO.

3 Joy "C"

FARM

COMPANY

Petroleum Inc.

CONTRACTOR

Garvey

Walters Pool


_____ Ft. from N. Line

990' _____ Ft. from S. Line

_____ Ft. from E. Line

990' _____ Ft. from W. Line

NE SW SW

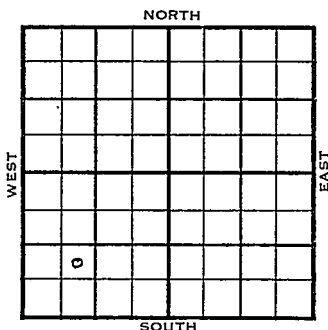

1955-	ELEVATION 2152	REPORT
-------	-------------------	--------

6/1 Spud 5-26-55
8" @ 256 w/150
Drlg 3185

6/15 DST 3410-3501, open 1 hr. Rec. 75' mud
450/30" DST 3659-65, open 1 hr. Rec 15'
oil 30' hocm 1000/30" DST 3665-70 open
1 hr. Rec 100' oil 30' muddy oil 200
hocm 1100/30" 5 $\frac{1}{2}$ @3665/75 CO to 3670
S/4 $\frac{1}{2}$ boph 200 A S/4.68 boph 1% wtr
S/5.85.boph 1% wtr. Comp .25 bopd .

Tops	Depth	Datum
Tp	3100	948
H.	3347	1195
Tr.	3364	1212
K. C. 3393		1241
Bkc	3616 1464	
S.	3646	1494
A.	3657	1505
TD	3670	

COMPLETED

County Ellis Elev. 2152Sec. 14 Twp. 12 Rge. 18WCompany Petroleum Inc.Farm Name Joy "C" No. 3

TOPS	DEPTH	LOG	DATUM	Loc. in Sec.
Anh.				NE SW SW
Tp.	3100		948	
H.	3347		1195	
Tr.	3364		1212	
Dg.				
Bl.				
L.	3393		1241	Geol.
K.C.				
B.K.C.	3616		1464	Contr.
Ce.				Garvey
C.				
M.				Pool
M.				
K.				Walters
Mz.				
Mo.				COMPLETE
V.				
S.	3646		1494	
S.				
A.	3657		1505	
R.				
PE.				
G.				
T.D.	3670			

Date Comm. 5-26-55

JUN 15 1955

8" @ 256/150 DST 3410-3501 open 1 hr.

Rec. 75' mud 450/30" DST 3659-65

open 1 hr. Rec. 15' oil 30' hocm

1000/30" DST 3665-70 open 1 hr. Rec.

100' oil 30' muddy oil 200' hocm

1100/30" 5 $\frac{1}{2}$ " @ 3665/75 CO to 3670S/ 4 $\frac{1}{2}$ boph 200 A S/ 4.68 boph 1% wtr

S/ 5.85 boph 1% wtr. Comp. 25 bopd