



Ellis

KANSAS

Sec. 14 Twp. 12 R. 18W

Well No. #4 Joy "G": Farm

Bill Graham Company

Graham Contractor

Walters Pool


Ft. from N. Line

990' Ft. from S. Line

Ft. from E. Line

330' Ft. from W. Line

NW SW NE

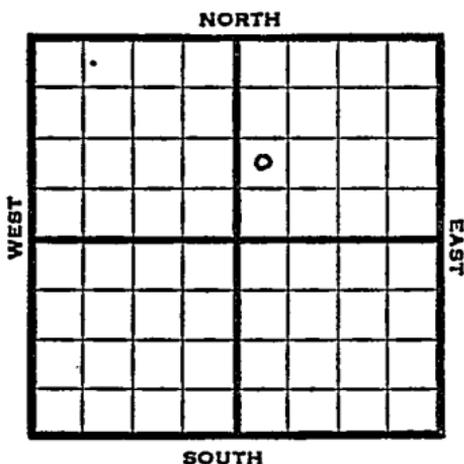

1949

Elev 2156'

REPORT

11/9

8" @ 170'

Anhy 1405'

Drlg. 2532'

11/16

TD 3700' in Cong.

Lansing 3387'

Cong 3669'

Aband.

**ABANDONED**

Map No. \_\_\_\_\_ Sec. 14 Twp. 12 R. 18W

Well No. 4 Joy "C"

Bill Graham \_\_\_\_\_ Company

Graham \_\_\_\_\_ Contractor

NW SW NE

FIRST REPORT  
SECTION PLAT

\_\_\_\_\_ Ft. from N. Line

990 Ft. from S. Line

\_\_\_\_\_ Ft. from E. Line

330 Ft. from W. Line

|  |  |   |  |
|--|--|---|--|
|  |  |   |  |
|  |  | o |  |
|  |  |   |  |
|  |  |   |  |
|  |  |   |  |

Ellis County

Location \_\_\_\_\_

Rig up \_\_\_\_\_

Drilling and Remarks:

8" @ 170'

Anhy 1405

drlg. 2532

RECORD

Cased \_\_\_\_\_ in., \_\_\_\_\_ ft.

Sand \_\_\_\_\_

Gas \_\_\_\_\_

Oil \_\_\_\_\_

Total Depth \_\_\_\_\_

PRODUCTION

1st 24 hrs. Nat. \_\_\_\_\_

1st 24 hrs. after shot \_\_\_\_\_

Gas \_\_\_\_\_ Cu. Ft.

Dry Hole \_\_\_\_\_

Abandoned \_\_\_\_\_

Date

NOV 9 1949 19

S. J. LEWIS

Scout

Map No. \_\_\_\_\_ Sec. 14 Twp. 12 R. 18W

Well No. 4 Joy "C"

Bill Graham Company

**ABANDONED**

Contractor

NW SW NE

*E. 2156*  
SECTION PLAT

\_\_\_\_\_ Ft. from N. Line

990 Ft. from S. Line

\_\_\_\_\_ Ft. from E. Line

330 Ft. from W. Line

|  |  |   |  |
|--|--|---|--|
|  |  |   |  |
|  |  | o |  |
|  |  |   |  |
|  |  |   |  |

Ellis County

Location \_\_\_\_\_

Rig up \_\_\_\_\_

Drilling and Remarks:

*Loss 3387*  
*Log 3669*

**RECORD**

Cased \_\_\_\_\_ in., \_\_\_\_\_ ft.

Sand \_\_\_\_\_

Gas \_\_\_\_\_

Oil \_\_\_\_\_

Total Depth 9700 in @ log

**PRODUCTION**

1st 24 hrs. Nat. \_\_\_\_\_

1st 24 hrs. after shot \_\_\_\_\_

Gas \_\_\_\_\_ Cu. Ft.

Dry Hole \_\_\_\_\_

Abandoned \_\_\_\_\_

Date

NOV 16 1949 19

S. J. LEWIS Scout