

KANSAS


Form 51-5M-7-39-Palace

Ellis

Section 14 Township 12 Range 18-W

Well No. #1 M. A. Joy

Company Bridgeport & Emrich

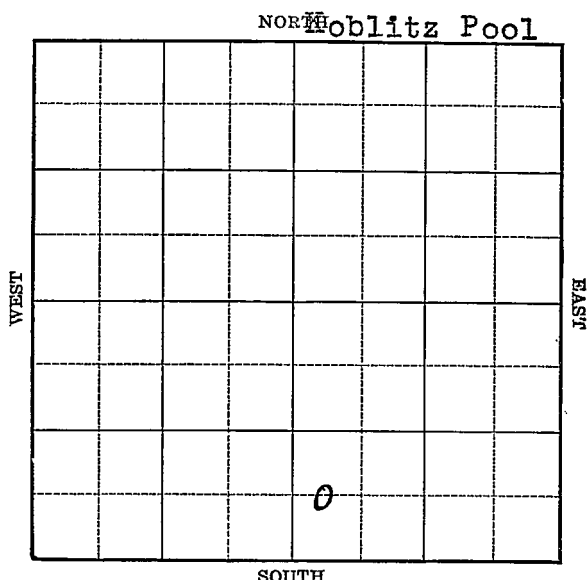

Ellis

KANSAS


Map No. 71 Sec. 14 Twp. 12 R. 18WWell No. 1 M. A. JoyBridgeport & Emrich Company

Contractor

FIRST REPO

C W L S $\frac{1}{2}$ SE

SECTION PLAT

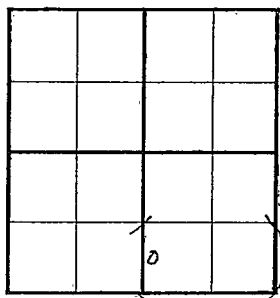 Ft. from N. Line660 Ft. from S. Line Ft. from E. Line330 Ft. from W. Line

KOBLITZ POOL

Location XRig up Drilling and Remarks:

RECORD

Cased in., ft.Sand Gas Oil Total Depth

PRODUCTION

1st 24 hrs. Nat. 1st 24 hrs. after shot Gas Cu. Ft.Dry Hole Abandoned

Date

OCT 21 1929₁₉

S. J. LEWIS

Scout

Ellis

KANSAS


Map No. 71 Sec. 14 Twp. 12 R. 18WWell No. 1 M. A. JoyBridgeport & Emrich Company

Contractor

ABANDONED

C W L S $\frac{1}{2}$ SE Ft. from N. Line660 Ft. from S. Line Ft. from E. Line330 Ft. from W. Line

SECTION PLAT

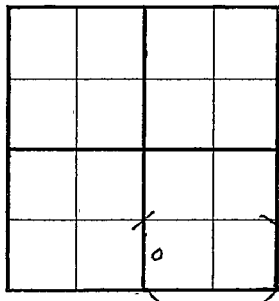

KOBELITZ POOL

Location Rig up

Drilling and Remarks:

*Oil 3731**No Test.*

RECORD

Cased in., ft.Sand Gas Oil Total Depth 3755

PRODUCTION

1st 24 hrs. Nat. 1st 24 hrs. after shot Gas Cu. Ft.Dry Hole Abandoned

Date

NOV 9 1939 19 C J LEWIS Scout