SIDE ONE

STATE CORPORATION COMMISSION OF KANSAS
OIL & GAS CONSERVATION DIVISION

WELL COMPLETION OR RECOMPLETION FORM
ACO-1 WELL HISTORY

DESCRIPTION OF WELL AND LEASE

Operator: license # 5146
name Rains & Williamson Oil Co., Inc.
address 435 Page Court, 220 W. Douglas
Wichita, KS 67202
City/State/Zip

Operator Contact Person Juanita Green
Phone 265-9686

Contractor: license #
name Rains & Williamson Oil Co., Inc.

Wellsite Geologist
Phone
PURCHASER

Designate **Type of Completion**
[X] New Well [ ] Re-Entry [ ] Workover

[ ] Oil [ ] SWD [ ] Temp Abd
[ ] Gas [ ] Inj [ ] Delayed Comp.
[X] Dry [ ] Other (Core, Water Supply etc.)

If **OWWO:** old well info as follows:
Operator
Well Name
Comp. Date Old Total Depth

API NO. 15 - 167-22,740

County Russell

NE SW NE (location) Sec 11 Twp 12S Rge 14 [X] W

3630 Ft North from Southeast Corner of Sect
1650 Ft West from Southeast Corner of Sect
(Note: locate well in section plat below)

Lease Name Finnesy Well# 1

Field Name

Producing Formation

Elevation: Ground 1655 KB 1660

Section Plat

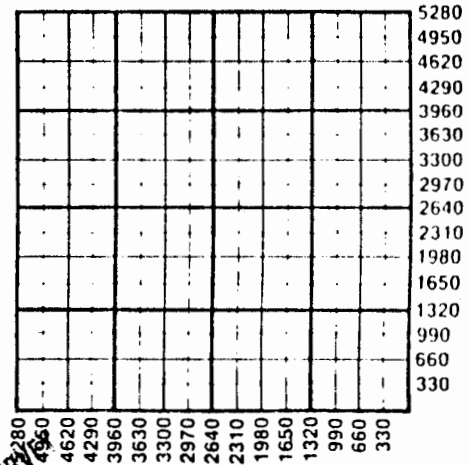

JUN 11 1986

KANSAS GEOLOGICAL SURVEY
WICHITA BRANCH

WELL HISTORY

Drilling Method: [X] Mud Rotary [ ] Air Rotary [ ] Cable

4-30-86 Spud Date | 5-5-86 Date Reached TD | 5-5-86 Completion Date

3155' Total Depth | PBTD

Amount of Surface Pipe Set and Cemented at 256' feet

Multiple Stage Cementing Collar Used? [ ] Yes [ ] No

If Yes, Show Depth Set feet

If alternate 2 completion, cement circulated
from feet depth to w/ SX cmt

WATER SUPPLY INFORMATION

Source of Water:
Division of Water Resources Permit #

[ ] Groundwater Ft North From Southeast Corner a
(Well) Ft. West From Southeast Corner
Sec Twp Rge [ ] East [ ] West

[ ] Surface Water Ft North From Sourtheast Corner a
(Stream, Pond etc.) Ft West From Southeast Cor
Sec Twp Rge [ ] East [ ] West

[ ] Other (explain)
(purchased from city, R.W.D.#)

Disposition of Produced Water: [ ] Disposal [ ] Repressuring

Docket #

INSTRUCTIONS: This form shall be completed in duplicate and filed with the Kansas Corporation Commission, 200 Colorado Derby Building, Kansas 67202, within 90 days after completion or recompletion of any well. Rules 82-3-130 and 82-3-107 apply.

Information on side two of this form will be held confidential for a period of 12 months if requested in writing and submitted with the form. See rule 82-3-10