

COPY

SIDE ONE

STATE CORPORATION COMMISSION OF KANSAS  
OIL & GAS CONSERVATION DIVISION  
WELL COMPLETION FORM  
ACO-1 WELL HISTORY  
DESCRIPTION OF WELL AND LEASE

Operator: License # 6194

Name: E.S.P. Development, Inc.

Address R.R. 1 Box 18

City/State/Zip Paradise, Kansas 67658

Purchaser: \_\_\_\_\_

Operator Contact Person: Lewis Eulert

Phone (913) 998-4413

Contractor: Name: Western Kansas Drilling, Inc.

License: 4083

Wellsite Geologist: Randall Kilian

Designate Type of Completion

☒ New Well ☐ Re-Entry ☐ Workover  
☐ Oil ☐ SWD ☐ Temp. Abd.  
☐ Gas ☐ Inj ☐ Delayed Comp.  
☒ Dry ☐ Other (Core, Water Supply, etc.)

If ~~OWO~~: old well info as follows:

Operator: \_\_\_\_\_

Well Name: \_\_\_\_\_

Comp. Date \_\_\_\_\_ Old Total Depth \_\_\_\_\_

Drilling Method:

☒ Mud Rotary ☐ Air Rotary ☐ Cable

6-11-91 6-17-91 6-18-91

Spud Date Date Reached TD Completion Date

API NO. 15- 167-22,978

County Russell

NW SE NE Sec. 32 Twp. 12 Rge. 14 XX East West

3630' Ft. North from Southeast Corner of Section

990' Ft. West from Southeast Corner of Section  
(NOTE: Locate well in section plat below.)


Lease Name Paradise South Well # B #1

Field Name Unknown

Producing Formation \_\_\_\_\_

Elevation: Ground 1705' KB 1710'

Total Depth 3210' PBD 3500'

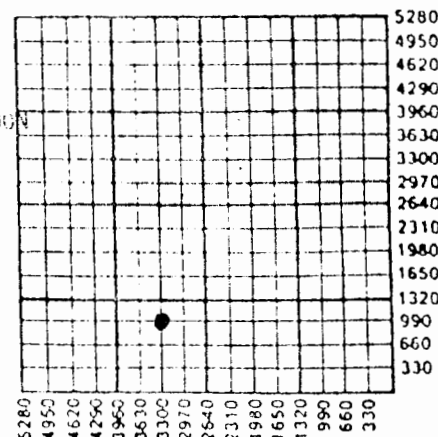

A 15 II D+A

Amount of Surface Pipe Set and Cemented at 213' Feet

Multiple Stage Cementing Collar Used? ☐ Yes ☐ No

If yes, show depth set \_\_\_\_\_ Feet

If Alternate II completion, cement circulated from \_\_\_\_\_

feet depth to \_\_\_\_\_ w/ \_\_\_\_\_ sx cmt.

INSTRUCTIONS: This form shall be completed in triplicate and filed with the Kansas Corporation Commission, 200 Colorado Derby Building, Wichita, Kansas 67202, within 120 days of the spud date of any well. Rule 82-3-130, 82-3-107 and 82-3-106 apply. Information on side two of this form will be held confidential for a period of 12 months if requested in writing and submitted with the form. See rule 82-3-107 for confidentiality in excess of 12 months. One copy of all wireline logs and drillers time log shall be attached with this form. ALL CEMENTING TICKETS MUST BE ATTACHED. Submit CP-4 form with all plugged wells. Submit CP-111 form with all temporarily abandoned wells. Any recompletion, workover or conversion of a well requires filing of ACO-2 within 120 days from commencement date of such work.

All requirements of the statutes, rules and regulations promulgated to regulate the oil and gas industry have been fully complied with and the statements herein are complete and correct to the best of my knowledge.


Signature Lewis Eulert

Title President Date 7/1/91

Subscribed and sworn to before me this 15th day of July, 19 91.

Notary Public Donna Super

Notary Commission Expires 2-9-93

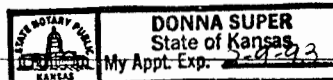

K.C.C. OFFICE USE ONLY		
F	<input type="checkbox"/>	Letter of Confidentiality Attached
C	<input type="checkbox"/>	Wireline Log Received
C	<input checked="" type="checkbox"/>	Drillers Timelog Received
Distribution		
<input checked="" type="checkbox"/>	KCC	<input type="checkbox"/>
<input checked="" type="checkbox"/>	KGS	<input type="checkbox"/>
<input type="checkbox"/>	SWD/Rep	<input type="checkbox"/>
<input type="checkbox"/>	Plug	<input checked="" type="checkbox"/>
<input type="checkbox"/>	NGPA	<input type="checkbox"/>
<input type="checkbox"/>	Other	(Specify)

COP

SIDE TWO

Operator Name E.S.P. Development, Inc. Lease Name Paradise South Well # B #1  
County Russell  
Sec. 32 Twp. 12 Rge. 14 ☐ East ☒ West

INSTRUCTIONS: Show important tops and base of formations penetrated. Detail all cores. Report all drill stem tests giving interval tested, time tool open and closed, flowing and shut-in pressures, whether shut-in pressure reached static level, hydrostatic pressures, bottom hole temperature, fluid recovery, and flow rates if gas to surface during test. Attach extra sheet if more space is needed. Attach copy of log.

Drill Stem Tests Taken ☒ Yes ☐ No  
(Attach Additional Sheets.)  
Samples Sent to Geological Survey ☐ Yes ☒ No  
Cores Taken ☐ Yes ☒ No  
Electric Log Run ☐ Yes ☒ No  
(Submit Copy.)

Formation Description

☐ Log ☒ Sample

Name	Top	Bottom
Anhydrite	756	+954
Topeka	2614	-906
Heebner	2834	-1134
Lansing	2898	-1188
Base Kc.	3148	-1438
Arbuckle	3199	-1489
RTD	3210	-1500

CASING RECORD

☐ New ☐ Used

Report all strings set-conductor, surface, intermediate, production, etc.

Purpose of String	Size Hole Drilled	Size Casing Set (In O.D.)	Weight Lbs./Ft.	Setting Depth	Type of Cement	# Sacks Used	Type and Percent Additives
Surface	12 1/4"	8 5/8	19#	213'	60/40 poz	135sks	2%gel 3%cc

PERFORATION RECORD

Shots Per Foot Specify Footage of Each Interval Perforated

Acid, Fracture, Shot, Cement Squeeze Record (Amount and Kind of Material Used) Depth


TUBING RECORD

Size

Set At

Packer At

Liner Run

☐ Yes ☐ No

Date of First Production

Producing Method

☐ Flowing ☐ Pumping ☐ Gas Lift ☐ Other (Explain)

Estimated Production Per 24 Hours

Oil

Bbls.

Gas

Mcf

Water

Bbls.

Gas-Oil Ratio

Gravity

Disposition of Gas:

METHOD OF COMPLETION

Production Interval

☐ Vented ☐ Sold ☐ Used on Lease  
(If vented, submit ACO-18.)

☐ Open Hole ☐ Perforation ☐ Dually Completed ☐ Commingled  
☐ Other (Specify) \_\_\_\_\_

DRILLER'S LOG

32-12-14W  
COPY

Operator: E.S.P. Development, Inc.

Contractor: Western Kansas Drilling, Inc.

Well & Well Description: Paradise South B #1  
NW-SE-NE 32-12-14 Russell County, Kansas

Commenced: 6-11-91

Completed: 6-18-91

Character of Well: D & A

Elevation: 1705' GL 1710' KB

Casing: Ran 7 jts. of 8 5/8's set @ 213'

Figures Indicate Bottom of Formations

0' - 754'	Sand & Shale	3117' - 3210'	Lime & Shale
754' - 792'	Anhy.		
792' - 1406'	Shale		
1406' - 1880'	Sand & Shale		
1880' - 2278'	Shale		
2278' - 2915'	Lime & Shale		
2915' - 2949'	Lime		
2949' - 3040'	Lime & Shale		
3040' - 3117'	Lime		

State of Kansas )  
County of Ellis ) ss:

I Stanley Younger, President of Western Kansas Drilling, Inc.  
upon oath state that the above and foregoing is a true and correct copy of  
the log of the Paradise South B #1

RECEIVED  
STATE OF KANSAS  
DIVISION

Stanley Younger, President

JUL 02 1991

COMPL. BY  
Wichita Falls