


All information Completely
like Required Affidavit
shall or Deliver Report to:
Conservation Division
State Corporation Commission
800 Bitting Building
Wichita, Kansas

WELL PLUGGING RECORD

NORTH

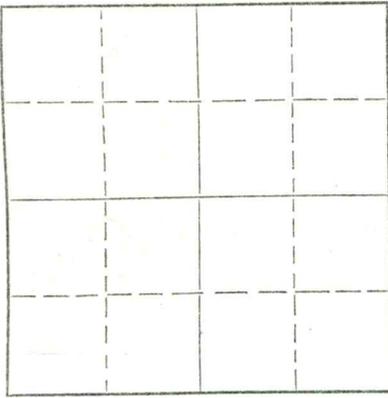

Locate well correctly on above
Section Plat

Russell County. Sec. 30 Twp. 12 Rge. 15 (E) W (W)
Location as "NE/CNW $\frac{1}{4}$ SW $\frac{1}{4}$ " or footage from lines CN $\frac{1}{2}$ SW $\frac{1}{4}$
Lease Owner B & R Drilling, Inc.
Lease Name Austin Well No. 1
Office Address Russell, Kansas
Character of Well (completed as Oil, Gas or Dry Hole) Oil
Date well completed 10/20/48 19
Application for plugging filed 2/14/52 19
Application for plugging approved 2/14/52 19
Plugging commenced 2/15/52 19
Plugging completed 2/17/52 19
Reason for abandonment of well or producing formation Dry Hole

If a producing well is abandoned, date of last production February 12, 1952 19
Was permission obtained from the Conservation Division or its agents before plugging was commenced? Yes

Name of Conservation Agent who supervised plugging of this well Eldon Petty
Producing formation _____ Depth to top _____ Bottom _____ Total Depth of Well 3333 Feet
Show depth and thickness of all water, oil and gas formations.

OIL, GAS OR WATER RECORDS

CASING RECORD

Formation	Content	From	To	Size	Put In	Pulled Out
				8 5/8"	198'	None
				5 1/2"	3331'	2584

Describe in detail the manner in which the well was plugged, indicating where the mud fluid was placed and the method or methods used in introducing it into the hole. If cement or other plugs were used, state the character of same and depth placed, from _____ feet to _____ feet for each plug set.

PLUGGING RECORD

Plugged back with crushed rock to 2950', dumped 5 sacks cement with dump bailer. Top of cement 2912'. Mudded hole to 198', set rock bridge, dumped 15 sacks cement. Top of cement 150'. Mudded hole to 35', set rock bridge dumped 10 sacks for cap.

(If additional description is necessary, use BACK of this sheet)

Name of Plugging Contractor Miller Casing Pulling Co.
Address Great Bend, Kansas

STATE OF KANSAS, COUNTY OF RUSSELL, ss.
W. A. Michaelis, Jr. (employee of owner) or (owner or operator) of the above-described well,
being first duly sworn on oath, says: That I have knowledge of the facts, statements, and matters herein contained and the log of the above-described well as filed and that the same are true and correct. So help me God.

(Signature) *W. A. Michaelis, Jr.*
Russell, Kansas
(Address)

SUBSCRIBED AND SWORN to before me this 25th day of February, 1952.
Clara Hummel
Notary Public.

My commission expires 6-17-54. 28-8390-s 6-51-20M

PLUGGING
FILE SEC 30 T 12 R 15 W
BOOK PAGE 144 LINE 24

FEB 27 1952
CONS. DIV. DIVISION
WICHITA, KANSAS