


Section 15 Township 12 S Range 17 WWell No. #1 HermanCompany G & G Drilling & Oil Trading

NORTH

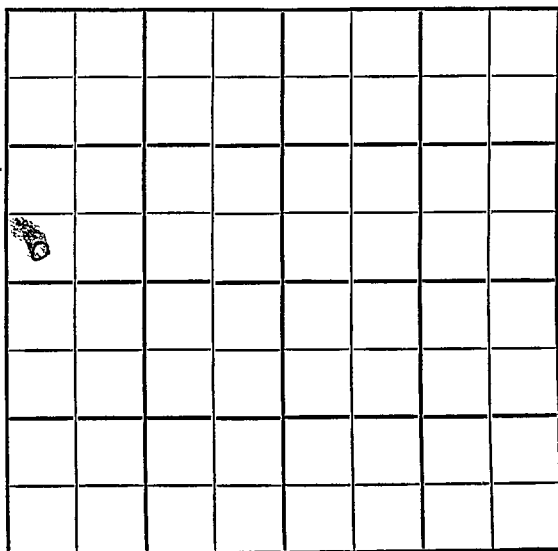

SOUTH

ELLIS

KANSAS

SEC.	15	TWP.	12S	R.	17W
------	----	------	-----	----	-----

WELL NO.

#1 Herman

FARM

COMPANY

C & G Drlg & Oil Trading

CONTRACTOR

Co. Tools


WILDCAT

_____ Ft. from N. Line

_____ Ft. from S. Line

_____ Ft. from E. Line

_____ Ft. from W. Line

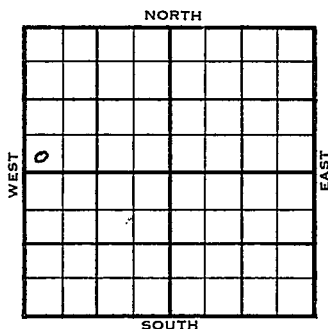

SW SW NW

Cont. DHM

	ELEVATION	REPORT
1955	2134'	

9/21	Comm 9/14/55	
	8" @ 187 W/150	
	Anh	1363
	D 2416	
9/28	Comm 9-14-55	
	8" @ 187/150	
	Anh	1363
	H	3359
	L	3406
	BKC	3650
	C	3666
	S	3717
	A	3743
	TD	3773
	D & A	

ABANDONED

County E1118

Elev. _____

Sec. 15Twp. 12SRge. 17WCompany C & G Drilg. & Oil TradingFarmName HermanNo. 1

TOPS

DEPTH

LOG

DATUM

Loc. in Sec. _____

Anb. _____

1363SW SW NW

Tp. _____

H. _____

Tr. _____

DS - NW/4

Dg. _____

Bl. _____

Cont. - DHM

L. _____

K.C. _____

Geol. _____

B.K.C. _____

Ce. _____

Contr. _____

C. _____

Co. tools

M. _____

M. _____

Pool _____

K. _____

Wildcat

Mz. _____

Mo. _____

V. _____

S. _____

S. _____

A. _____

R. _____

Pe. _____

G. _____

FIRST REPORT

T.D. _____

Date Comm. 9-11-55

SEP 21 1955

8" 187 w/150; D 2416

County ENLIS Elev. 2134
 Sec. 15 Twp. (12) Rge. 17W
 Company G & G Drilg. & Oil Trading
 Farm Name Herman No. 1

TOPS	DEPTH	LOG	DATUM
Anh.	1363		
Tr.			
H.	3359		1225
Dg.			
BL.			
L.	3400		1272
K.C.			
B.K.C.	3650		1510
Ce.			
C.	3666		1532
M.			
M.			
K.			
Mz.			
Me.			
V.			
S.	3717		1583
S.			
A.	3743		1609
R.			
Pe.			
G.			
T.D.	3773		

Loc. in Sec. _____

SW SW NW

Geol. _____

Contr. _____

Co. tools

Pool

Wildcat

ABANDONED

Date Comm. 9-14-55

SEP 28 1955

8" @ 187/150

D. & A.