


Ellis

Section 15 Township 12 Range 17W

Well No. 1-Miller

Company Lee Phillips

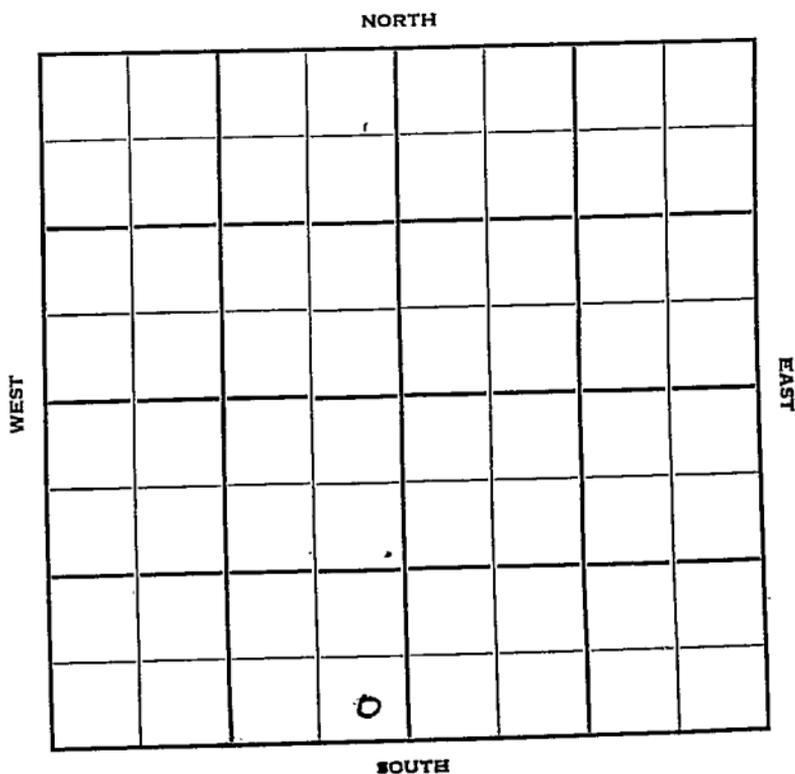

Sec. 15 Twp. 12 R. 17W

Well No. #1 Miller Farm

Lee Phillips Company

Strain Drlg. Contractor


Wildcat

 Ft. from N. Line

330 Ft. from S. Line

330 Ft. from E. Line

 Ft. from W. Line

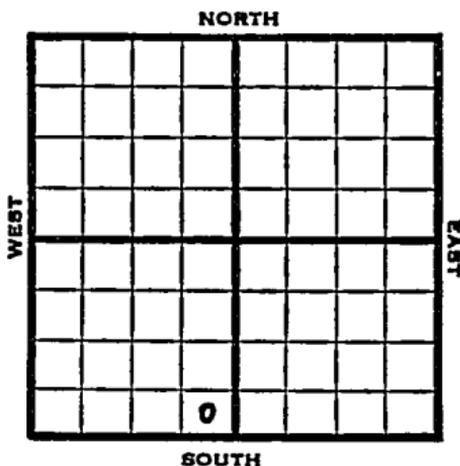

SE SE SW
Phillips Farmout

1953 Elev. 2137' REPORT

1/21 Spud 1-15-53
8" @ 180
Anhy 1349
Drlg. 2695'

1/28 Spud 1-15-53
D&A
TD 3705
8" @ 180
Anhy 1349, Heeb 3354, Tor 3375,
Lans 3399, Cong 3673
DST 3675-82, opn 35 mins., rec.
5' mud, 2 5#
TD 3705
D&A

ABANDONED

