


Section 15 Township 12 Range 18WWell No. #1 Baker "A"Company C & G Drlg.

NORTH

WEST

EAST

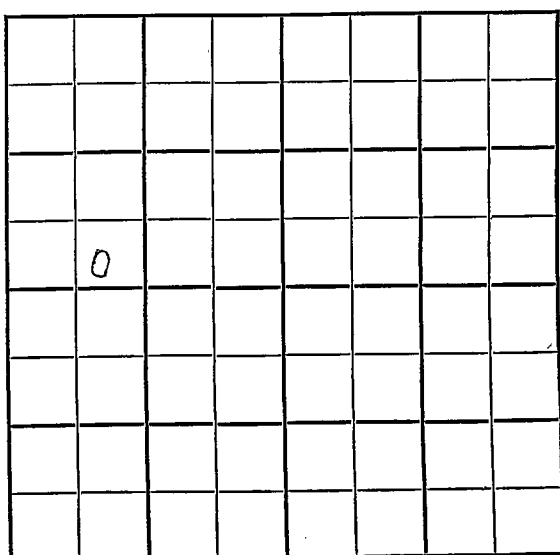

SOUTH

Ellis KANSAS

SEC.	TWP.	R.
15	12	18W

WELL NO. FARM

1 Baker "A"

COMPANY

C & G Drlg.

CONTRACTOR

Co tools

~~Walter Pool~~
NW Koblitz Pool

Ft. from N. Line

330


Ft. from S. Line

Ft. from E. Line

990

Ft. from W. Line

SE SW NW

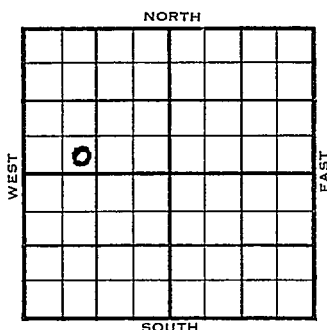

1954

ELEVATION

2192'

REPORT

8-25


Location

11/23

Spud 9-15-54 Oil well TD 3721
8" @ 178 Anhy 1445 Top. 3143
Heeb 3385 Tor. 3405 KC 3427
DST 3177-3285 open 1 hr rec 55' SW
740#
DST 3342-56 open 45 min rec 108' OGM
790#
DST 3464-80 open 1 hr rec 200' gas,
65' HMC 780#
DST 3521-41 open 1 hr rec 265' muddy SW
830# Arb. 3712 TD 3721 5" @ 3718
CO to 3721 S/2 BOPH 500 A S/7 BOPH
Comp. 36 BOPD

COMPLETED

FABEN GILSTRAN

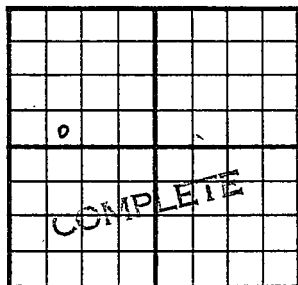County Ellis State KansasSec. 15 (Blk. 12 (Sur. 18W Map No.)
(Twp.) (Rge.)Operator C & G Drlg.Well No. 1 Farm Baker "A"Elev. 2192 Location SE SW NW330 Ft. From S Line NW990 Ft. From W Line QuarterIst. Report. Completion NOV 23 1954Remarks NWKoblitz PoolCo. toolsSpudding Date 9-15-54Drlg. Data Oil well TD 37218" @ 178 Anhy 1445 Top. 3143Heeb. 3385 Tor. 3405 KC 3427DST 3177-3285 open 1 hr. Rec. 55' sw740# DST 3342-56 open 45 min. Rec.108' ocm 790# DST 3464-80 open 1 hr.Rec. 200' gas 65' hmco 780# DST 3521-41 open 1 hr. Rec. 265' muddy sw 830#Arb. 3712 TD 3721 5" @ 3718 CO to 3721S/ 2 boph 500 A S/ 7 bophComp. 36 bopd

FADEN GU STD