


Section 15 Township 12 Range 18WWell No. #2 ByersCompany Carl Lebaack

NORTH

WEST

EAST

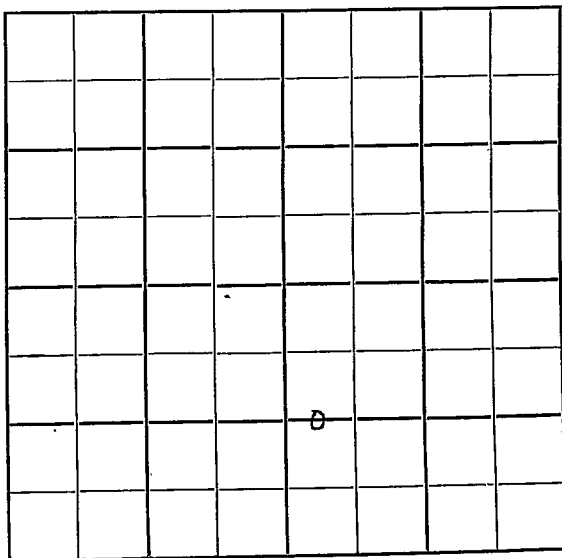

SOUTH

Ellis KANSAS

Sec. 15 Twp. 12 R. 18^W

Well No. #2 Byers Farm

Carl Lebsack Company

Contractor


Ft. from N. Line

1320' Ft. from S. Line

Ft. from E. Line

330' Ft. from W. Line

C $W\frac{1}{2}$ $W\frac{1}{2}$ SE

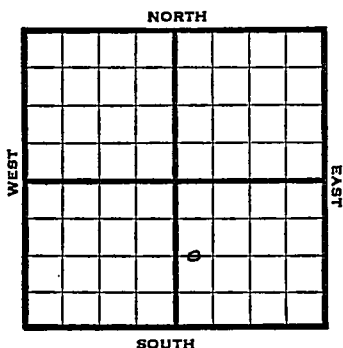

1950 Elev. 2177' REPORT

5/3 Spud 4-28-50
8" @200'
Anhy 1444'
Drlg. 2400'

5/10 TD 3726
8" @ 200
Hub 3379
Lans 3425
Cong 3677
Anb 3718
No show
Dry and Abandoned

ABANDONED

Kansas

Map No. _____ Sec. 15 Twp. 12 R. 18WWell No. 2 Byers_____
Carl Lebsack Company_____
ContractorC. $W\frac{1}{2}$ $W\frac{1}{2}$ SeE. 2177
SECTION PLAT_____
Ft. from N. Line1320 Ft. from S. Line_____
Ft. from E. Line330 Ft. from W. Line

Ellis County

Location _____

Rig up _____

Drilling and Remarks:

Spud 4-28-50

8" @ 200

Anhy 1444

drlg. 2400

RECORD

Cased _____ in., _____ ft.

Sand _____

Gas _____

Oil _____

Total Depth _____

PRODUCTION

1st 24 hrs. Nat. _____

1st 24 hrs. after shot _____

Gas _____ Cu. Ft.

Dry Hole _____

Abandoned _____

Date


MAY 3 1950 19

J. E. TYRA Scout

Kansas

Map No. 15 Sec. 15 Twp. 12 R. 18WWell No. 2 BversCarl Lehsack Company

Contractor

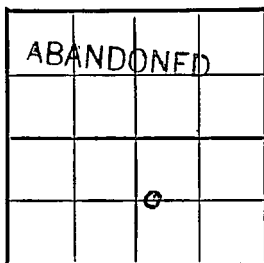CW₂¹ W₂¹ SEEI. 2177
SECTION PLAT Ft. from N. Line1320 Ft. from S. Line Ft. from E. Line330 Ft. from W. LineEllisLocation Rig up

Drilling and Remarks:

8" @ 200Hub 3379Lans 3425cong 3677alt 3718no showD + A

RECORD

Cased in., ft.Sand Gas Oil Total Depth 3726

PRODUCTION

1st 24 hrs. Nat. 1st 24 hrs. after shot Gas Cu. Ft.Dry Hole Abandoned

Date

MAY 10 195019J. E. TYRA Scout