


Section 15 Township 12 Range 18W

Well No. 2 Karlin

Company Petroleum, Inc.

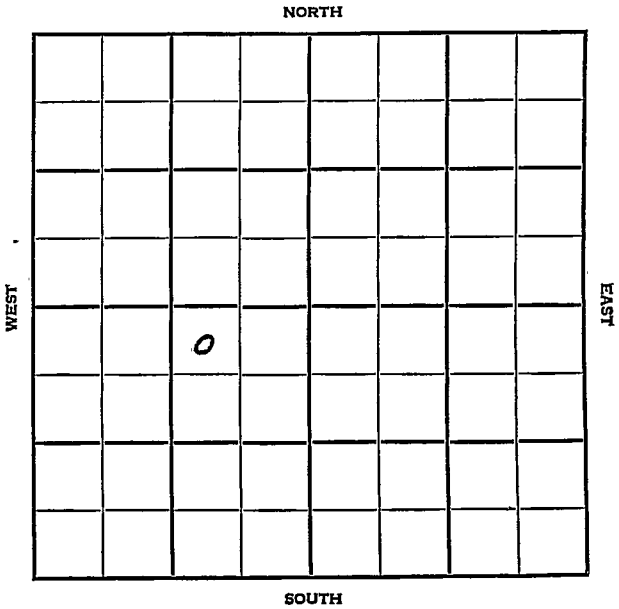

Ellis KANSAS

SEC.	TWP.	R.
15	12	18 W
WELL NO.		
# 2 Karlin		FARM
COMPANY		
Petroleum Inc.		
CONTRACTOR		
Garvey		


Koblitz Pool

330 _____ Ft. from N. Line

_____ Ft. from S. Line

990 _____ Ft. from E. Line

_____ Ft. from W. Line

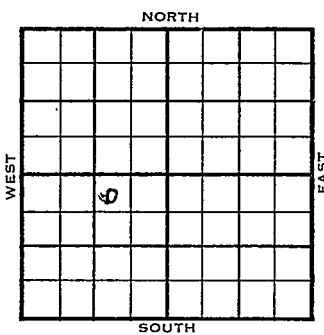

NW NE SW

1954	ELEVATION	REPORT
	2180'	
10/20	MIR	
12/15	Spud 10-19-54	
	Oil Well	
	TD 3716'	
	8" @ 185'	
	DST 3310'-50' opn 1 hr, rec 3260' gas	
	30' ho & gcm 600' f roggy oil	
	950# Heeb 3370' Lans 3412'	
	DST 3421'-50' opn 1 hr, rec 20' hocm	
	0#	
	DST 3455'-65' opn 1 hr, gas in 55 min	
	rec 480' oil 825#	
	DST 3492'-3535' opn 45 min rec 13' Mud	
	0# Arb. 3698'	
	DST 3699'-3708' opn 1 hr, rec 420' oil	
	30' hocm, 250#	
	TD 3708'	
	5" @ 3701'	
	DD 3712'	
	S/ 5 1/2 boph 500 A FU 540' oil 12hr.	
	DD 3716'	
	2000 A S/ 9 1/2 boph 6% Wtr. 8 hr.	
	Comp 159bopd. 20% Wtr.	
		COMPLETED

County **Ellis** State **Kansas**

Sec. **15** (Blk. Twp.) **12** (Sur. Rge.) **18W** Map No.

Operator **Petroleum Inc.**

Well No. **2** Farm **Karlin**

Elev. Location **NW NE SW**

FIRST REPORT					

330 Ft. From **N** Line **SW**

990 Ft. From **E** Line Quarter

1st. Report **OCT 20 1954**

Completion

Remarks

Garvey - Contr.

Spudding Date

Drlg. Data **Koblitz Pool**

M I R

FABEN GILSTRAP

County Ellis State Kansas
 Sec. 15 (Blk. 12 (Sur. 18W Map No. 12) (Rge.)
 Operator Petroleum Inc.
 Well No. 2 Farm Karlin
 Elev. 2180 Location NW NE SW

330 Ft. From N Line SW
990 Ft. From E Line Quarter
 Ist. Report
 Completion DEC 15 1954
 Remarks Koblitz Pool
Garvey - Contr.
 Spudding Date 10-19-54

Drlg. Data Oil well TD 3716
8" @ 185 DST 3310-50 open 1 hr. Rec.
3260' gas 30' ho & gcm 600' froggy oil
950# Heeb. 3370 Lans. 3412 DST 3421-50
open 1 hr. Rec. 20' hocom 0# DST 3455-65
open 1 hr. gas in 55 min. Rec. 480' oil
825# DST 3492-3535 open 45 min.
Rec. 13' mud 0# Arb. 3698 DST 3699-3708
open 1 hr. Rec. 420' oil 30' hocom
250# TD 3708 5" @ 3701 DD 3712
S/ 5 1/2 boph 500 A FU 540' oil 12 hr.
DD 3716 2000 A S/ 9 1/2 boph 6% wtr. 8 hrs
Comp. 159 bopd 20% wtr.

FACEN GILSTRAP