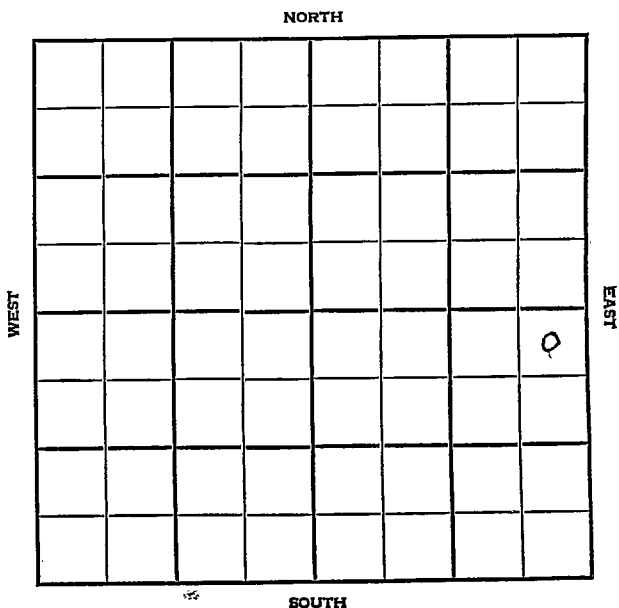


Section 15 Township 12 Range 18 WWell No. #1 ByersCompany Carl Lebsack

Ellis

KANSAS

SEC.	TWP.	R.
15	12	18 ^W

WELL NO.

#4 Byers

FARM

COMPANY

Carl Lebsack

CONTRACTOR

Isern


NW Koblitz

_____ Ft. from N. Line

_____ Ft. from S. Line

_____ Ft. from E. Line

_____ Ft. from W. Line

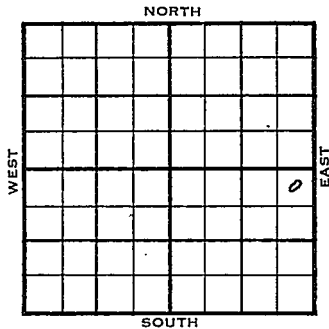

NE NE SE

1955

ELEVATION

2150

REPORT

10/5

Location

11/9

Comm 10-2-55

8 5/8" @ 142/100

Anh 1406

H 3351

L 3395

S 3658

A 3670

TD 3710

DST 3673-77 open 1 hr rec 10' mud

0/20" DST 3678-86 open 1 hr rec 15'

mud 0/20" DST 3690-3710 open 1 hr

rec 30' mud 0/30"

D & A

ABANDONED




TOPS

DEPTH

LOG

DATUM

Loc. in Sec.

NE NE SE

Anb.

Tp.

H.

Tr.

Dg.

BL.

L.

K.C.

B.K.C.

Ce.

C.

M.

M.

K.

Mz.

Mq.

V.

S.

S.

A.

R.

PE.

G.

T.D.

Geol.

Contr.

Tsern

Pool

NW Kobliem

FIRST REPORT

OCT 5 '55

0

Date Comm.

Location

Co.

Lse.

No.

Sec.

T.

R.

County Ellis Elev. 2150
 Sec. 15 Twp. (12) Rge. 18W
 Company Carl Lebsack
 Farm Name B yers No. 4

TOPS	DEPTH	LOG	DATUM	Loc. in Sec.
Anh.	<u>1406</u>			NE NE SE
Tr.	<u>3351</u>		<u>1201</u>	
Dg.				
BL.				
L.	<u>3395</u>		<u>1245</u>	Geol.
K.C.				Contr.
B.K.C.				Isern
Ce.				Pool
C.				Koblitz
M.				
M.				
K.				
Mz.				
Mo.				
V.				
S.	<u>3658</u>		<u>1508</u>	
S.				
A.	<u>3670</u>		<u>1520</u>	
R.				
Pe.				
G.				
T.D.	<u>3710</u>			

ABANDONED

Date Comm. 10-2-55 NOV 9 1955

8 5/8" @ 142/100 DST 3673-77

open 1 hr. rec. 10' mud 0/20"

DST 3678-86 open 1 hr. rec. 15' mud

0/20" DST 3690-3710 open 1 hr.

rec. 30' mud 0/30"

D & A