

TYPE

AFFIDAVIT OF COMPLETION FORM

ACO-1 WELL HISTORY

28-12-17W

Compt. _____

gms

SIDE ONE

Two (2) copies of this form shall be filed with the Kansas Corporation Commission, 200 Colorado Derby Building, Wichita, Kansas 67202, within thirty (30) days after the completion of a well, regardless of how the well was completed.

F Attach separate letter of request if the information is to be held confidential. If confidential, only file one copy. Information on Side One will be of public record and Side Two will then be held confidential.

Applications must be made on dual completion, commingling, salt water disposal, injection and temporarily abandoned wells.

C Attach one copy only wireline logs (i.e. electrical log, sonic log, gamma ray neutron log, etc.). (Rules 82-2-105 & 82-2-125) KCC# (316) 263-3238.

LICENSE # 6037 EXPIRATION DATE June - 84

OPERATOR Staab Oil Company API NO. 15-051-23754

ADDRESS HC 39, Box 114 COUNTY Ellis

Hays, Ks. 67601 FIELD Schmeidler

** CONTACT PERSON Francis Staab PROD. FORMATION Arber K10
PHONE 913-625-5013 KCC-KCC

PURCHASER N C R A LEASE Staab Farmer

ADDRESS McPherson Ks WELL NO. 1-T

DRILLING Helberg Oil Company 1575Ft. from North Line and


CONTRACTOR CONTRACTOR ADDRESS Box 32 1575Ft. from East Line of

Morland, Ks. 67650 the NE (Qtr.) SEC 28 TWP 12 RGE 17 (E) (W)

PLUGGING CONTRACTOR ADDRESS

WELL PLAT

(Office Use Only)

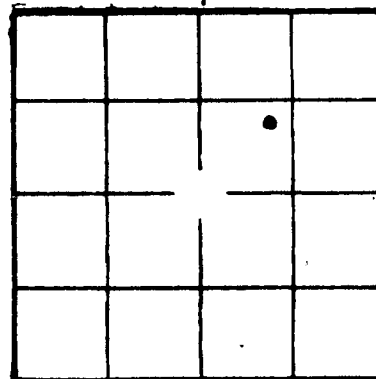

KCC _____
KGS
SWD/REP _____
PLG. _____

TOTAL DEPTH 3750' PBSD

SPUD DATE 12-30-1983 DATE COMPLETED 1-11-1984

ELEV: GR 2134 DF 2136 KB 2139

DRILLED WITH (CABLE) (ROTARY) (AIR) TOOLS.

DOCKET NO. OF DISPOSAL OR REPRESSURING WELL BEING USED TO DISPOSE OF WATER FROM THIS LEASE

Amount of surface pipe set and cemented 224' DV Tool Used? _____

THIS AFFIDAVIT APPLIES TO: (Circle ONE) (Oil) Gas, Shut-in Gas, Dry, Disposal, Injection, Temporarily Abandoned, OWWO. Other _____

ALL REQUIREMENTS OF THE STATUTES, RULES AND REGULATIONS PROMULGATED TO REGULATE THE OIL AND GAS INDUSTRY HAVE BEEN FULLY COMPLIED WITH.

A F F I D A V I T

Francis C Staab, being of lawful age, hereby certifies that:

I am the Affiant, and I am familiar with the contents of the foregoing Affidavit. The statements and allegations contained therein are true and correct.

Staab Oil Co