


KANSAS CORPORATION COMMISSION

WELL RECORD

32-12-17W

(Mail to Kansas Geological Survey, 4150 Monroe Street, Wichita, Kansas 67209)

APL #15-051-20,805

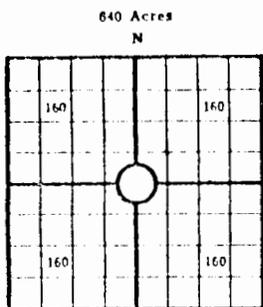

Locate well correctly

Lease Name: Giebler Well No. 1
 Well Located: Ellis County
SW SE NW SEC 32 TWP 12S RGE 17W
 Operator: Beacon Resources Corporation
 Address: 1000 Century Plaza Wichita, Ks. 67202
 Elevation: Ground 2054' D.F. 2056' K.B. 2059'
 Type Well: (Oil, gas, dry hole) D&A

Drilling Commenced: 2/12 19 72 Drilling Completed: 2/19 1972
 Well Completed: - 19 Total Depth 3630'
 Initial Production: -

Casing Record

Size: 8-5/8" Set at 253' Size: _____ Set at _____
 Size: _____ Set at _____ Size: _____ Set at _____

Liner Record

Size: None Set from _____ To _____

Cementing

<u>Casing Size</u>	<u>Sacks</u>	<u>Type Cement and Additives</u>
<u>8-5/8"</u>	<u>175</u>	<u>SS Common</u>
_____	_____	_____
_____	_____	_____

Perforations

<u>Formation</u>	<u>Perforated Interval and Number Shots</u>
<u>None</u>	_____
_____	_____
_____	_____
_____	_____

Electric Log Run (Show type log and depths covered)

Did not run log


Show Drill Stem Tests,
Well Stimulation and
Production Tests

Formation Top Bottom

DST #1 3383-3408; 30-30-30-30; weak blow/30 min. Rec'd. 15' mud. BHP 160# - 80#; FP 32#-40#; T-103^o.
 DST #2 3406-15'; 30-30-30-30; Rec'd. 65' wtry. mud; BHOP 216# - 144#; FP 48# - 56#; T- 106^o.
 DST #3 3474-3520'; 30-30-30-30; 15' mud; BHP 120# - 96#; FP 56# - 56#; T- 105^o.

TOPS

HYDRITE	1277 (+782)
B/ANHYDRITE	1320 (+739)
TOPEKA	3025 (-965)
WERNER	3284 (-1225)
WINTON	3304 (-1245)
WISING	3328 (-1296)
B/KANSAS CITY	3569 (-1510)
RTD	3639 (-1571)

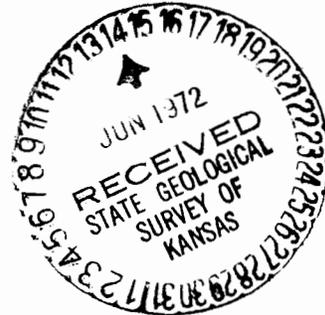

10/2/72